

III Maryland Avenue | Rockville, Maryland 20850-2364 | 240-314-5000 www.rockvillemd.gov

# **Development Review Comments**

October 4, 2023 PAM2023-00149 Submission Review Comments 414 – 416 Hungerford Drive

The following are Development Review comments from City of Rockville staff related to the project submission.

# **Reviewing Staff**

# Community Planning & Development Services (CPDS)

## Project Manager:

Nelson Ortiz, Principal Planner nortiz@rockvillemd.gov

#### **Comprehensive Planning Reviewer:**

Katie Gerbes (KG), Comprehensive Planning Manager kgerbes@rockvillemd.gov

#### **Forestry Reviewer:**

Shaun Ryan (SR), Development Review Supervisor <a href="mailto:srvan@rockvillemd.gov">srvan@rockvillemd.gov</a>

#### Fire Reviewer:

Charles Biggus (CB), Fire Plans Examiner <a href="mailto:cbiggus@rockvillemd.gov">cbiggus@rockvillemd.gov</a>

#### **Building Reviewer:**

Chris Dempwolf (CD), Buildings Plan Examiner Supervisor <a href="mailto:cdempwolf@rockvillemd.gov">cdempwolf@rockvillemd.gov</a>

# Dept. of Public Works (DPW)

#### **Engineering Reviewer:**

Sean Murphy (SM), Principal Civil Engineer <a href="mailto:smurphy@rockvillemd.gov">smurphy@rockvillemd.gov</a>

#### **Traffic and Transportation Reviewers:**

Andrew Luetkemeier (AWL), Principal Transportation Engineer <u>aluetkemier@rockvillemd.gov</u>

Faramarz Mokhtari (FM), Senior Transportation Planner <a href="mailto:fmokhtari@rockvillemd.gov">fmokhtari@rockvillemd.gov</a> PAM2023-00149 Development Review Letter October 4, 2023 Page 2

# Housing and Community Development (HCD)

**Housing Reviewer:** 

Punam Thukral (PT), Housing Specialist <a href="mailto:pthukral@rockvillemd.gov">pthukral@rockvillemd.gov</a>

# Recreation and Parks (RPD)

Parks Reviewer:

Christine Henry (CH), Deputy Director <a href="mailto:chenry@rockvillemd.gov">chenry@rockvillemd.gov</a>

## **PDS Comments**

#### **Development & Zoning**

- 1. The purpose of a Pre-Application Meeting (PAM) with the Development Review Committee (DRC) is not to approve/disapprove aspects of a development plan. It is a meeting that provides an early opportunity for City Staff to give general advice to an applicant in the preparation of a site plan, project plan, or special exception, to discuss the application process and schedule going forward, and to address any concerns raised by the community. Staff strives to identify major issues but does not perform a full and complete review for compliance with all aspects of the code, which is done at the application phase.
  - a. The subject site is currently designated OCRM (Office Commercial Residential Mix) and CRM (Commercial Residential Mix) by the Comprehensive Plan and is zoned MXCD (Mixed-Use Corridor District). Additionally, the site is located within the Town Center Performance District.
  - b. An 8-story, 345 dwelling unit, multi-family building with onsite amenities and structured parking as well as open space and the dedication of Maryland Avenue extension is proposed.
  - c. Per Sec. 25.13.03, multi-unit dwelling is a permitted use in the MXCD zone.
- 2. Per Sec. 25.07.02, the proposed development appears to have a point valuation of 9. A Level 2 site plan based on the point valuation and Sec. 25.07.02.b.3 that states "for any property within the Town Center Performance District any development application that totals between one (1) and fifteen (15) points will be acted upon by the Approving Authority under the Level 2 site plan process".
  - a. Tract size of 2.6 to 5 acres = 3
  - b. 345 or greater dwelling units = 4
  - c. No non-residential space = 0
  - d. Residential Impact Area =  $2^1$
  - e. Traffic Impact of fewer than 30 trips (reduction from previous use) = 0
  - f. Points Total = 9

#### 3. Land Use Planning Process:

- a. A Level 2 site plan application is required following finalization of PAM2023-00149. Please refer to the Level 2 site plan application checklist for all required submittal items.
- b. Following approval of the Level 2 Site Plan application, a "signature set" will be required for final approval.
- c. A Plat will be required to consolidate the Lots 8 and 12, dedication of Maryland Avenue ROW, and possibly park/open space.

\_

<sup>&</sup>lt;sup>1</sup> Estimated using GIS

#### 4. Land Use Review Timelines:

- a. Level 2 Site Plan: initial submittal review is 6 weeks; subsequent reviews are 3-4 weeks; final submittal due 7 weeks before the initial Planning Commission hearing.
- b. Level 2 Site Plan Signature Set: initial submittal review is 2 weeks; subsequent reviews are 1-2 weeks.
- c. Plat: initial submittal review is 3 weeks; subsequent reviews are 2 weeks; final submittal due 6 weeks before the initial Planning Commission hearing.
- d. Total typical review timeline is highly variable depending on applicant submittal timelines and responsiveness to City comments and requests.
- 5. Provide building elevations for all sides. Refer to Sec. 25.13.06.b for aesthetic and visual characteristic guidelines applicable to the proposed multi-family building.
- 6. Section 25.13.07.b.2 states that "the ground floor must contain retail or service uses dealing directly with the public along those streets designated in the plan as major pedestrian spines...". The 2001 Town Center Master Plan (TCMP) identifies the Maryland Avenue extension as a major pedestrian spine. The City of Rockville is in the process of updating the TCMP. Recommend further coordination with CPDS Comprehensive Planning Section.
- 7. Provide a property survey. Plats No. 9079 and 9506 reference easements on the subject property. Provide status of such easements. Have any easements been relinquished?
- 8. See plan markups for additional comments.

#### Comprehensive Planning (KG)

- 1. This application is largely compliant with the City's Comprehensive Plan. The application is located within Planning Area 1. Several elements of the project application are compliant with goals, policies, and actions outlined in the Comprehensive Plan.
- 2. Project 4 within Planning Area 1 calls to, "design Maryland Avenue as a continuous commercial corridor between East Montgomery Avenue and Dawson Avenue. The extension of Maryland Avenue between Beall Avenue and Dawson Avenue should include streetscape amenities, such as wide sidewalks, significant landscaped areas, street trees, decorative lighting, wayfinding and landmark elements, outdoor seating, on-street parking, and bike facilities." (page 260) This is reiterated in Land Use and Urban Design policy #3 within the Planning Area 1 chapter, which states to, "continue development of the L-shaped 'spine', extending along East Montgomery Avenue and Maryland Avenue, with a mix of ground-floor commercial, service, and entertainment uses; and office, residential, and institutional uses located above." (page 261)
  - a. The applicant is proposing to continue Maryland Avenue by dedicating land to serve as an extension of the roadway. The 72-foot right of way proposed

by the applicant will contain one lane of traffic in each direction, street parking and a sidewalk buffered by a landscaping strip. This extension is of great importance to the City. The desire for an extension of Maryland Avenue has been a goal for more than two decades, as it was first introduced in the 2001 Town Center Master Plan. Staff are encouraged to see the applicant's conformance with this element of the Town Center Master Plan and Comprehensive Plan, as it will assist in completing the street grid in Rockville's downtown.

- 3. The property is within Focus Area 4 of Planning Area 1 in the Comprehensive Plan. The plans states that, "redevelopment of property in this area should contribute toward a pedestrian-oriented, urban-scale streetscape. New developments should orient primary building facades and front doors toward a street or public open space to frame the edges of streets, parks, and open spaces, and to foster activated pedestrian areas. Building frontages should include ground-floor uses that attract customers or regular visitors, enhanced pedestrian areas and amenities, attractive landscaping, and bicycle infrastructure." (page 260) This is further supported by Land Use & Urban Design Policy #4 within Planning Area 1, which states, "buildings with ground-level parking and blank building walls should not be allowed along street edges, especially along Maryland Avenue, East Middle Lane, North Washington Street, Courthouse Square, and East Montgomery Avenue." (page 261)
  - a. The applicant is proposing to activate Maryland Avenue by locating the primary building entrance along the street, as well as activate the frontage of the building with amenities and high traffic uses such as lobbies and coworking centers within the building. While Maryland Avenue will be the "front" of the building, the applicant should also take care to treat the building façade along Hungerford Drive with adequate fenestration and design elements so that it is not perceived as the "back" of the building. Ideally an additional entrance to the building will be provided along Hungerford Drive.
- 4. The Comprehensive Plan states some aggressive goals towards the development of new and additional housing units at a variety of income levels. Specifically, Housing policy 32 states, "increase the number of residents and housing density in Town Center, to provide additional housing options for residents across the full range of income levels and to provide additional demand for the commercial uses in this mixed-use environment." (page 263).
  - a. The applicant is proposing 345 net new residential units, of which 51 will be MPDUs, aligning with this and other housing policies noted in the Comprehensive Plan.
- 5. In many places throughout the Comprehensive Plan the creation of a public park in the vicinity of the project site is recommended. This desire can be found within the Planning Area 1 chapter as:

Focus Area 4 - "A future public park is recommended in the general location where the green asterisk is places on the Land Use Policy Map Figure 44. The asterisk indicates the City's intention to establish a public park in this general area, either by means of land dedication as part of a development project, purchase, land swap or some other method, that would serve as a small gathering and amenity spaces for visitors to the area." (page 259).

Recreation & Parks Policy Recommendation #9 - "Study the potential for a new public park in Town Center that can be used for large public events, music concerts, theater performances, farmers markets, and holiday festivals; and for passive recreation and relaxation at other times." (page 262)

Recreation & Parks Policy Recommendation #11 - "Small urban parks should be maintained and added to enhance the pedestrian environment throughout Town Center and serve as locations for public landmarks." (page 262)

a. The applicant shows the creation of two triangular "outparcels" that would be created west of the Maryland Avenue extension. In their project narrative, the applicant indicated that the use of those parcels has not been determined at this time. Staff would like to see those parcels become parks or other open space amenities to be compliant with this element of the Comprehensive Plan. Staff encourage the applicant to work with the city, particularly the Department of Recreation and Parks, to determine a use for these two parcels that meets the needs and goals of both the applicant and the City.

#### Forestry (SR)

1. See plan mark-ups.

#### Fire (CB)

1. See site plan for comment markups.

#### **Building (CD)**

1. No comments at this time.

### **DPW Comments**

#### **Engineering (SM)**

- 1. See site plan for comment markups.
- 2. Pre-App SWM Concept comments provided separately.

PAM2023-00149 Development Review Letter October 4, 2023 Page 7

#### Traffic and Transportation (AWL/FM)

1. See site plan for comment markups.

## **HCD Comments**

#### Housing (PT)


- 1. The applicant is required to provide 15% of the total units as MPDU.
- Residential units constructed on this site must comply with the standards and requirements of the Rockville Moderately Priced Dwelling Unit Chapter 13.5 of the Rockville City Code.
- 3. Staff want the applicant to identify the location of MPDU units, which must be distributed throughout the building in all sections and levels of the building, so as not to concentrate all MPDUs in one section(s) of the building.
- 4. The MPDUs should be indistinguishable from the market rate units.
- 5. The MPDUs must be income tiered at three income bands—50%, 60% and 80% of AMI.
- 6. The applicant must provide the list of all the MPDU units and site plan.
- 7. The staff would like to propose that the applicant must designate a few ADA/UFAS (accessible) units within the MPDU.
- 8. Before applying of any building permits, an MPDU Rental Offering Agreement must be executed and MPDU Declaration of Covenants and Restrictions must be recorded in a form approved by the Mayor and Council and the Office of the City Attorney.


### **RPD Comments**

#### **Parks**


- 1. The City recommends that the two parcels, labeled as "future open space" on the site, be dedicated to the City for park land. Further coordination with the Applicant will be necessary for the dedication, design, and improvements of this space. At this time, the City's Parks and Recreation Department is interested in utilizing this space for a dog park with two separate areas serving small and large dogs.
- Publicly Accessible Art in Private Development Ordinance will apply to this project.
   Link to ordinance, manual, and application: <u>Publicly Accessible Art | Rockville, MD Official Website (rockvillemd.gov)</u>


Note: At the time of the next submittal, the applicant will need to provide a pointby-point response letter noting how the staff review comments have been addressed. Comments provided in letter format can be addressed letter format. Comments provided in the plans should be addressed via plan markups rather than letter format. See attached example.

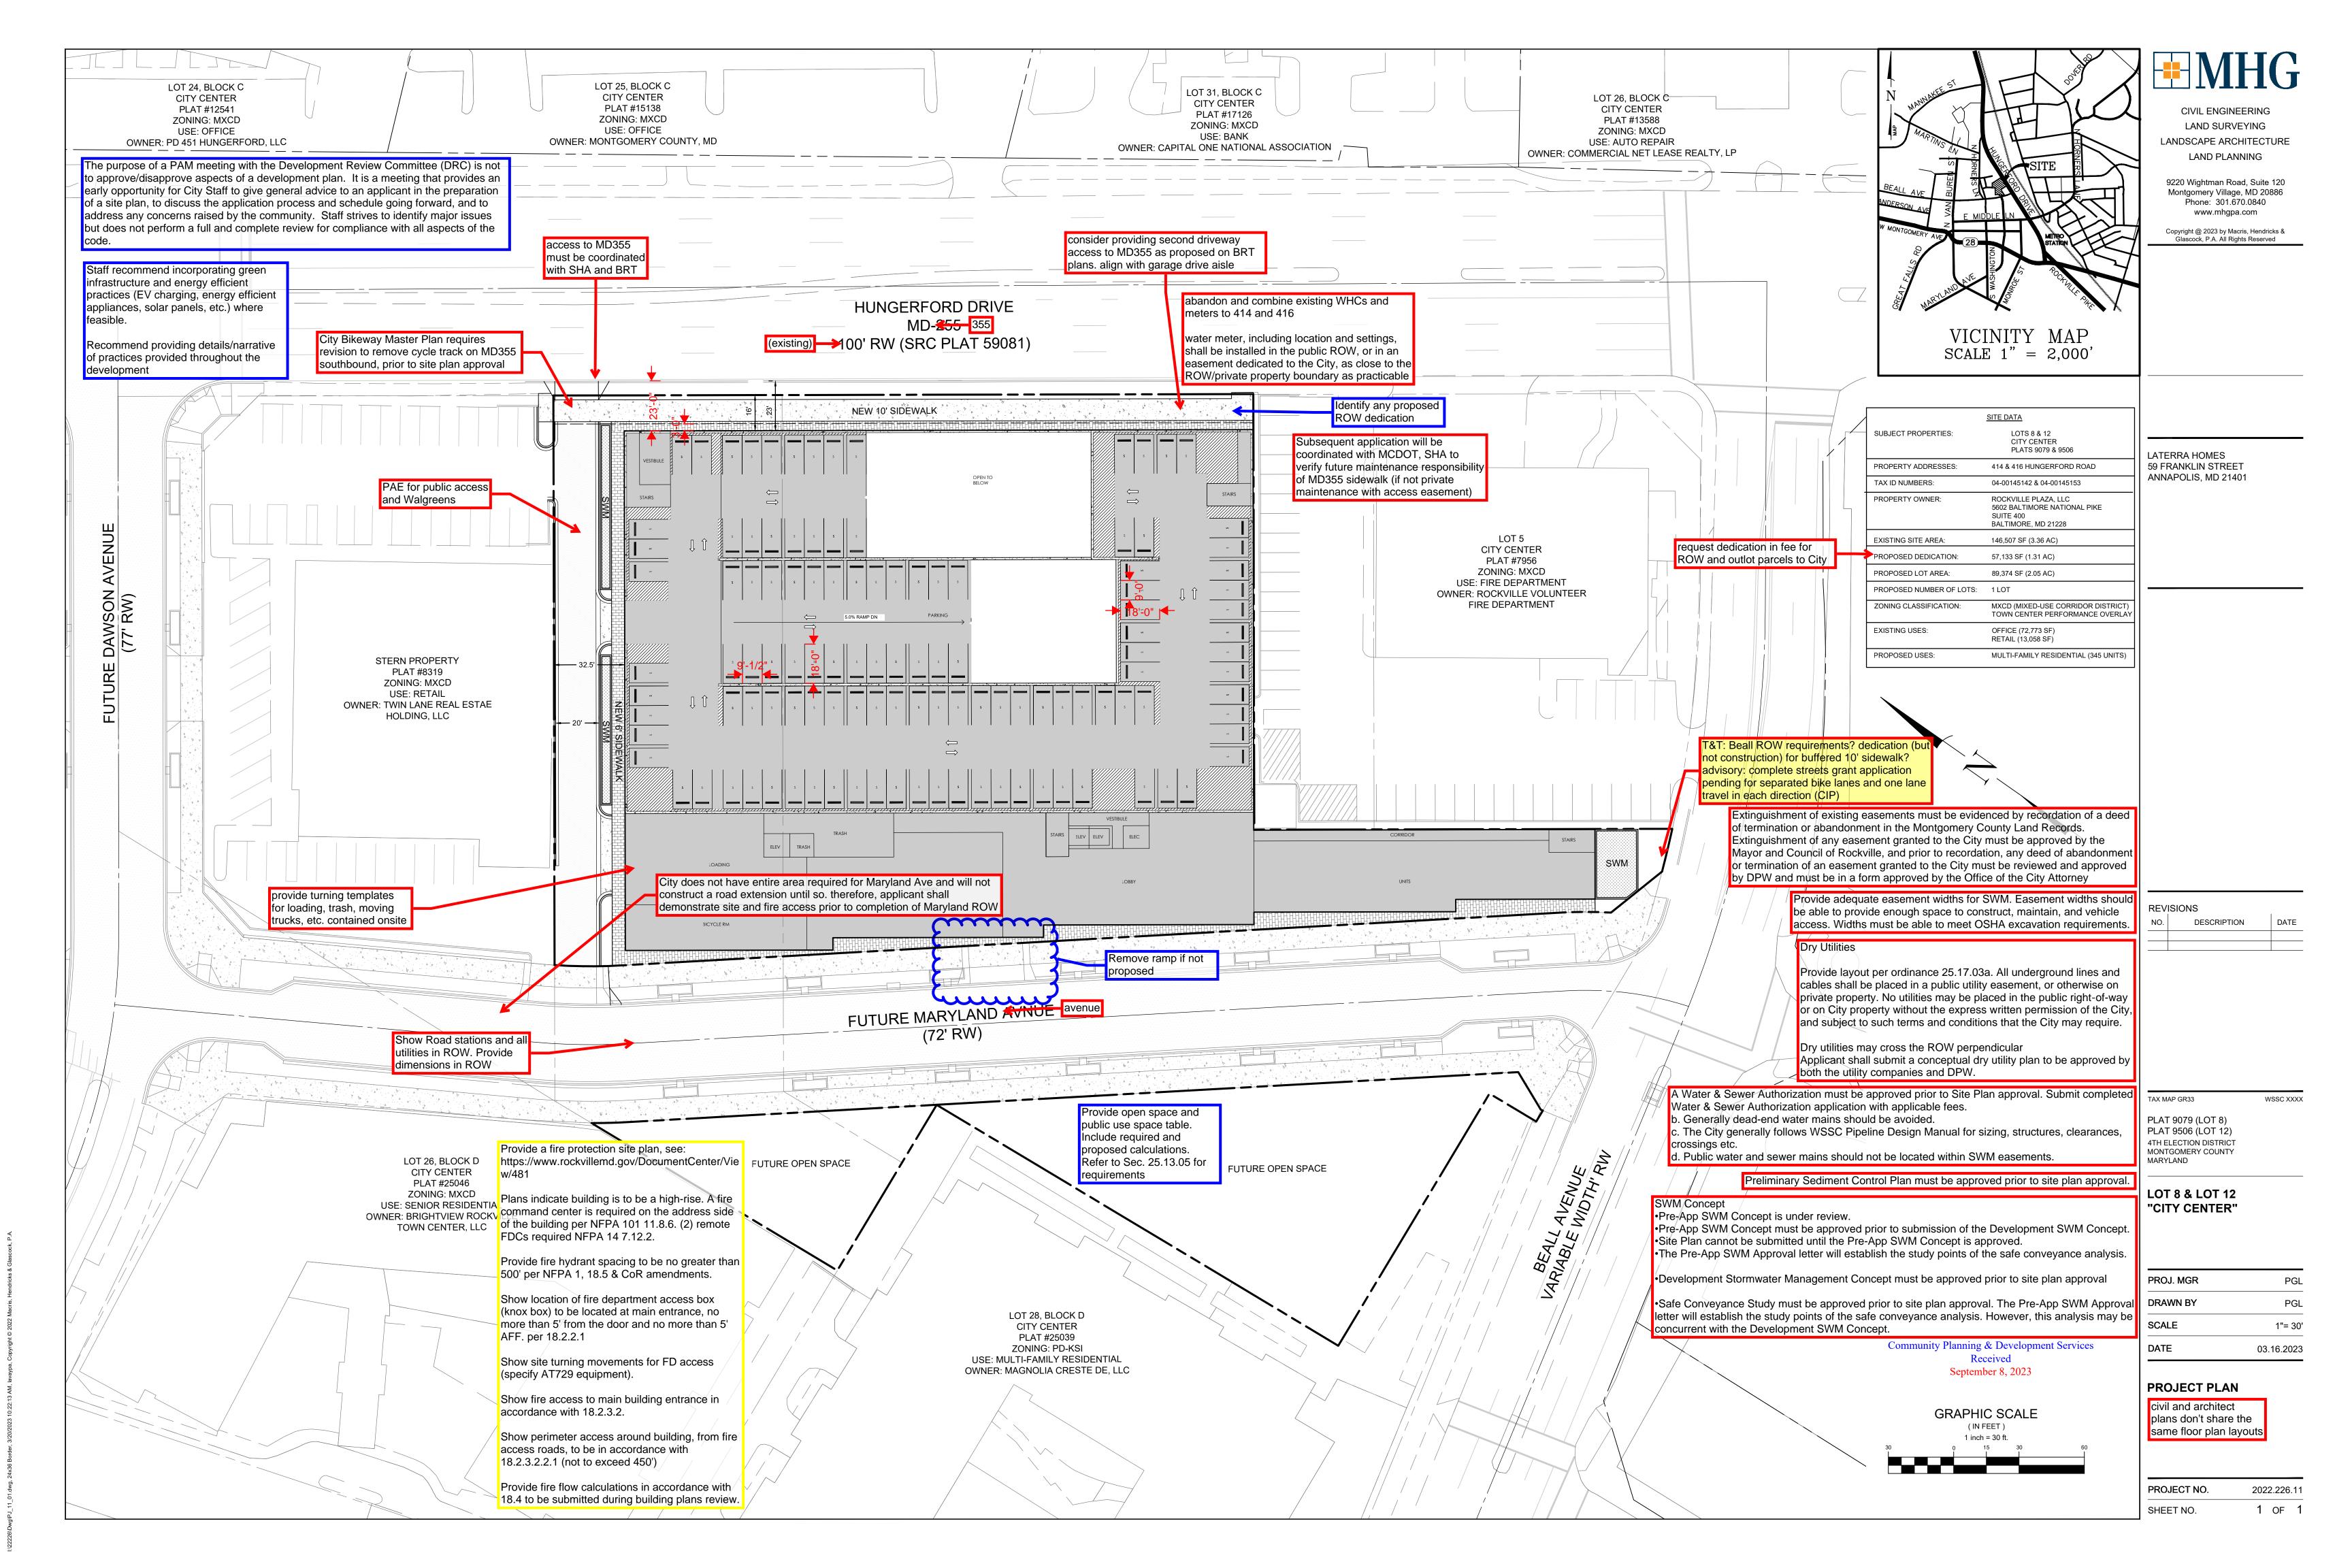


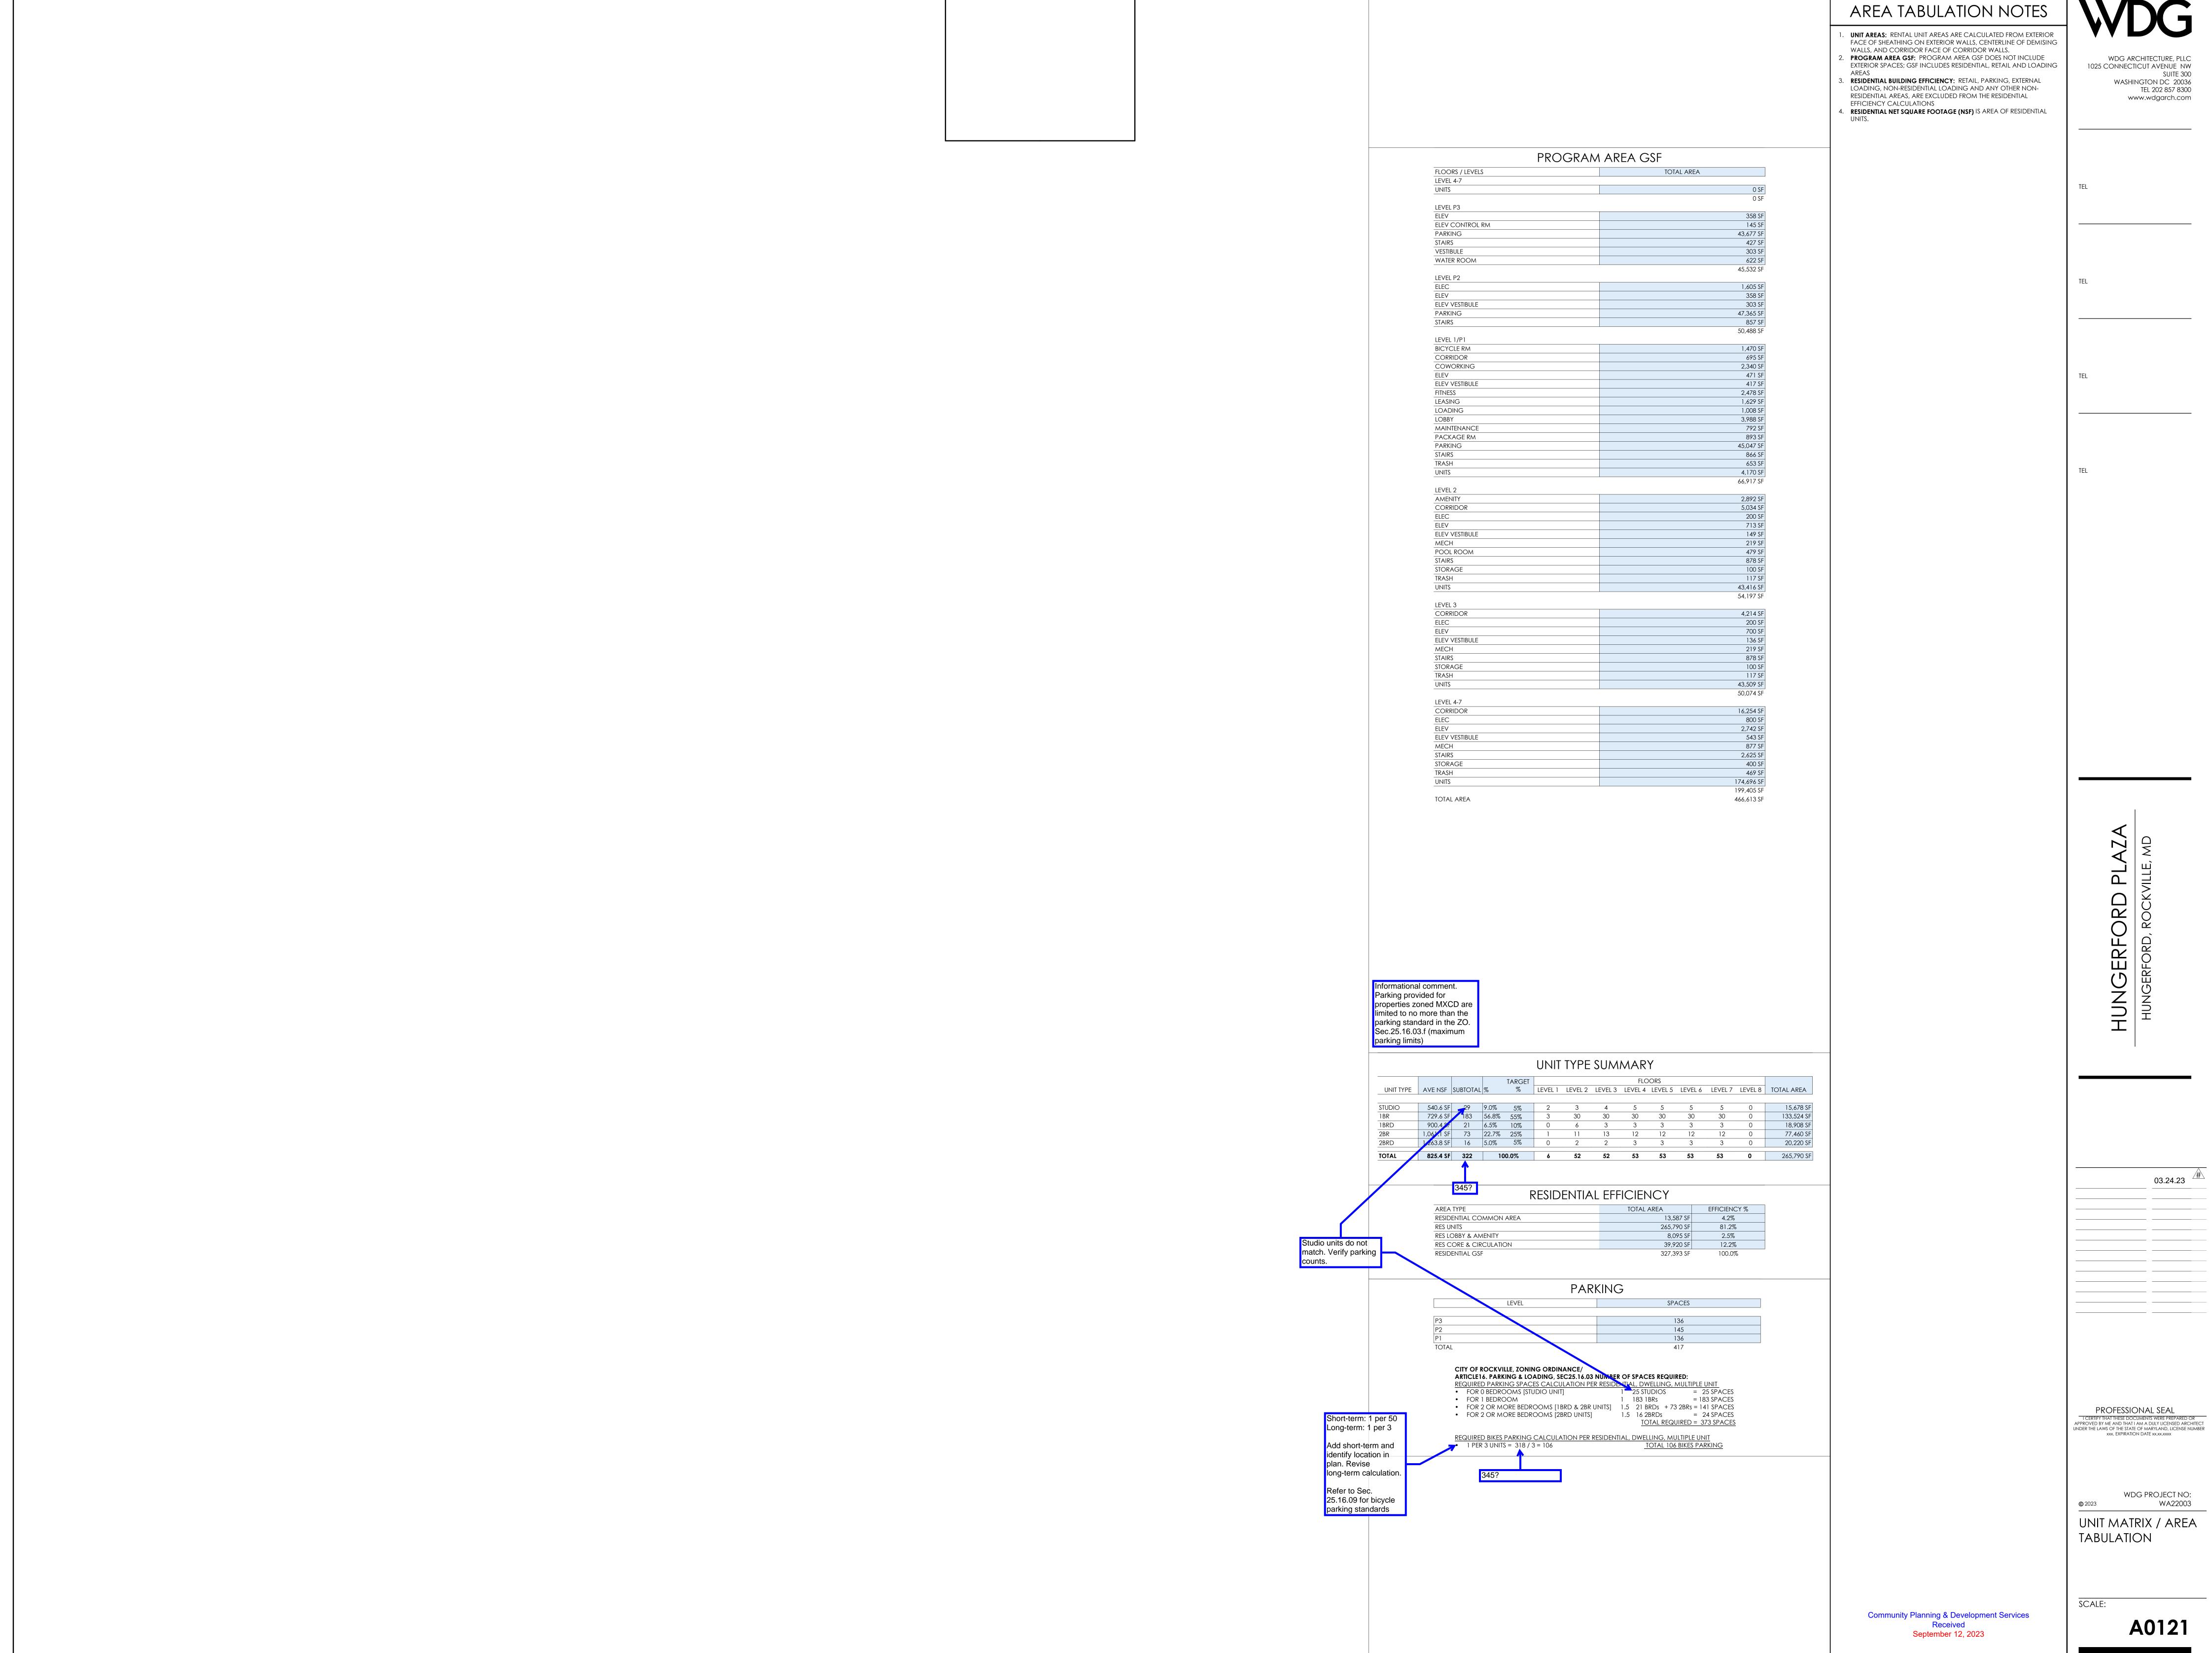


03.24.23

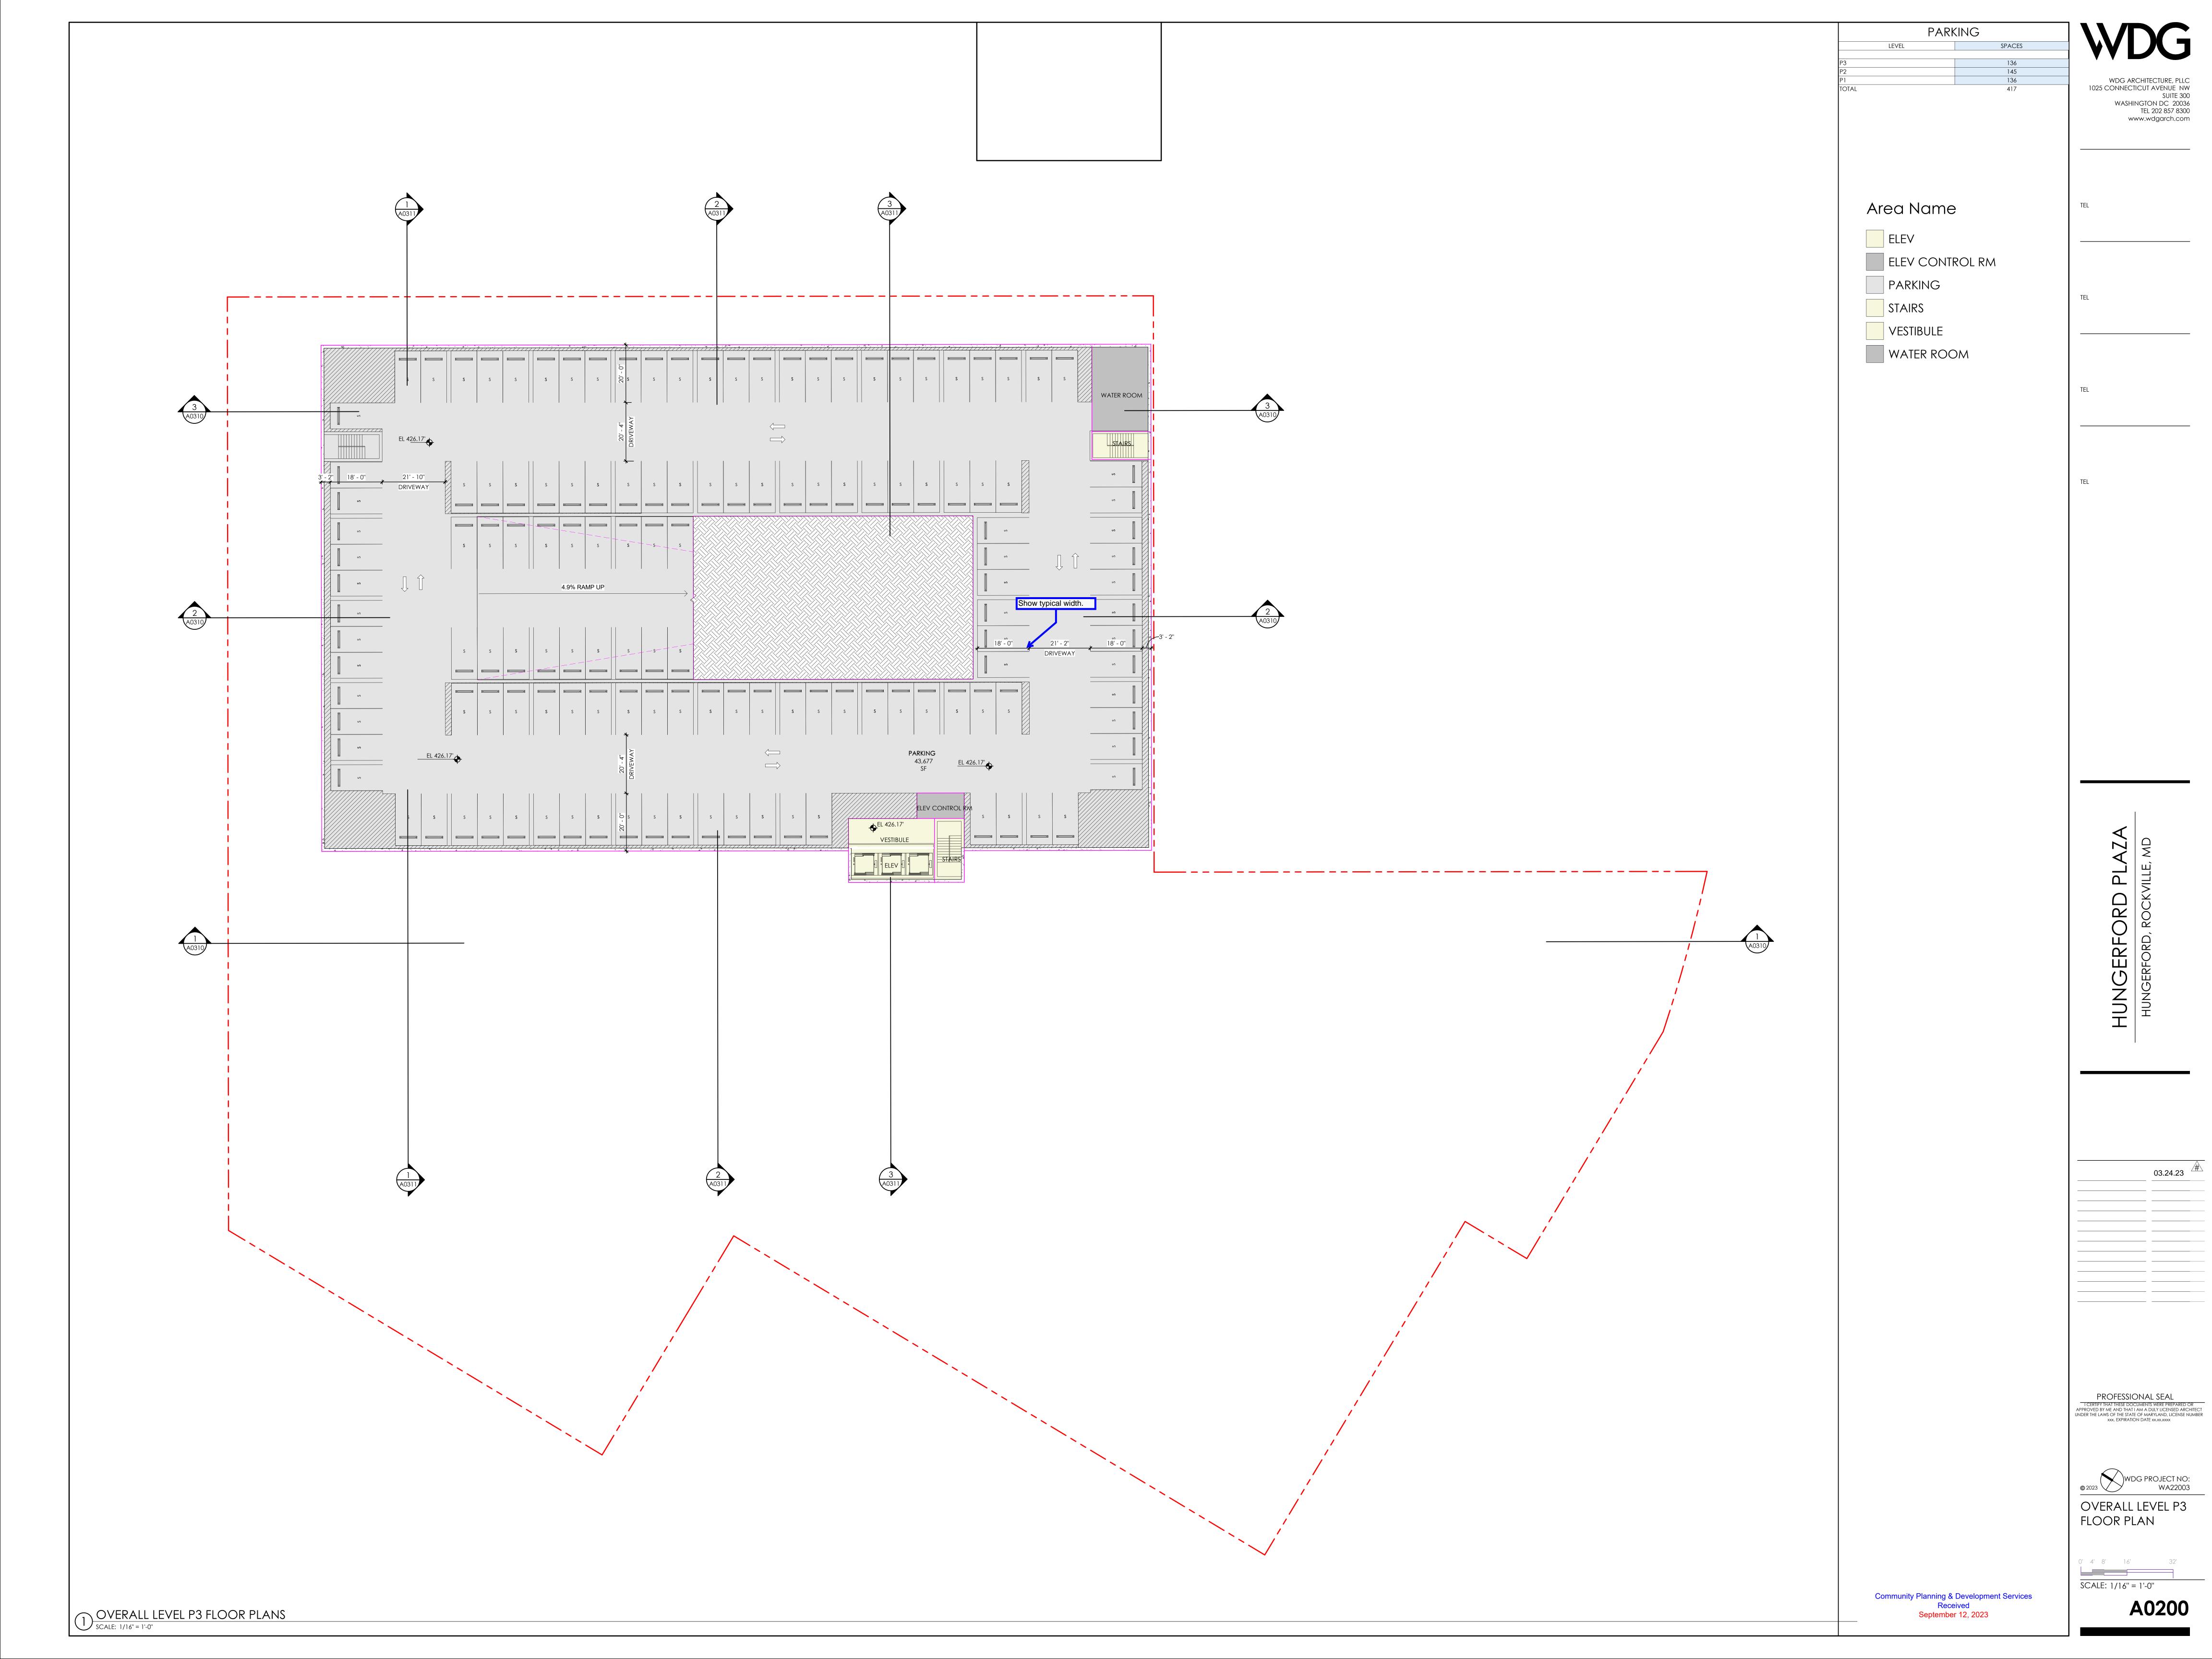

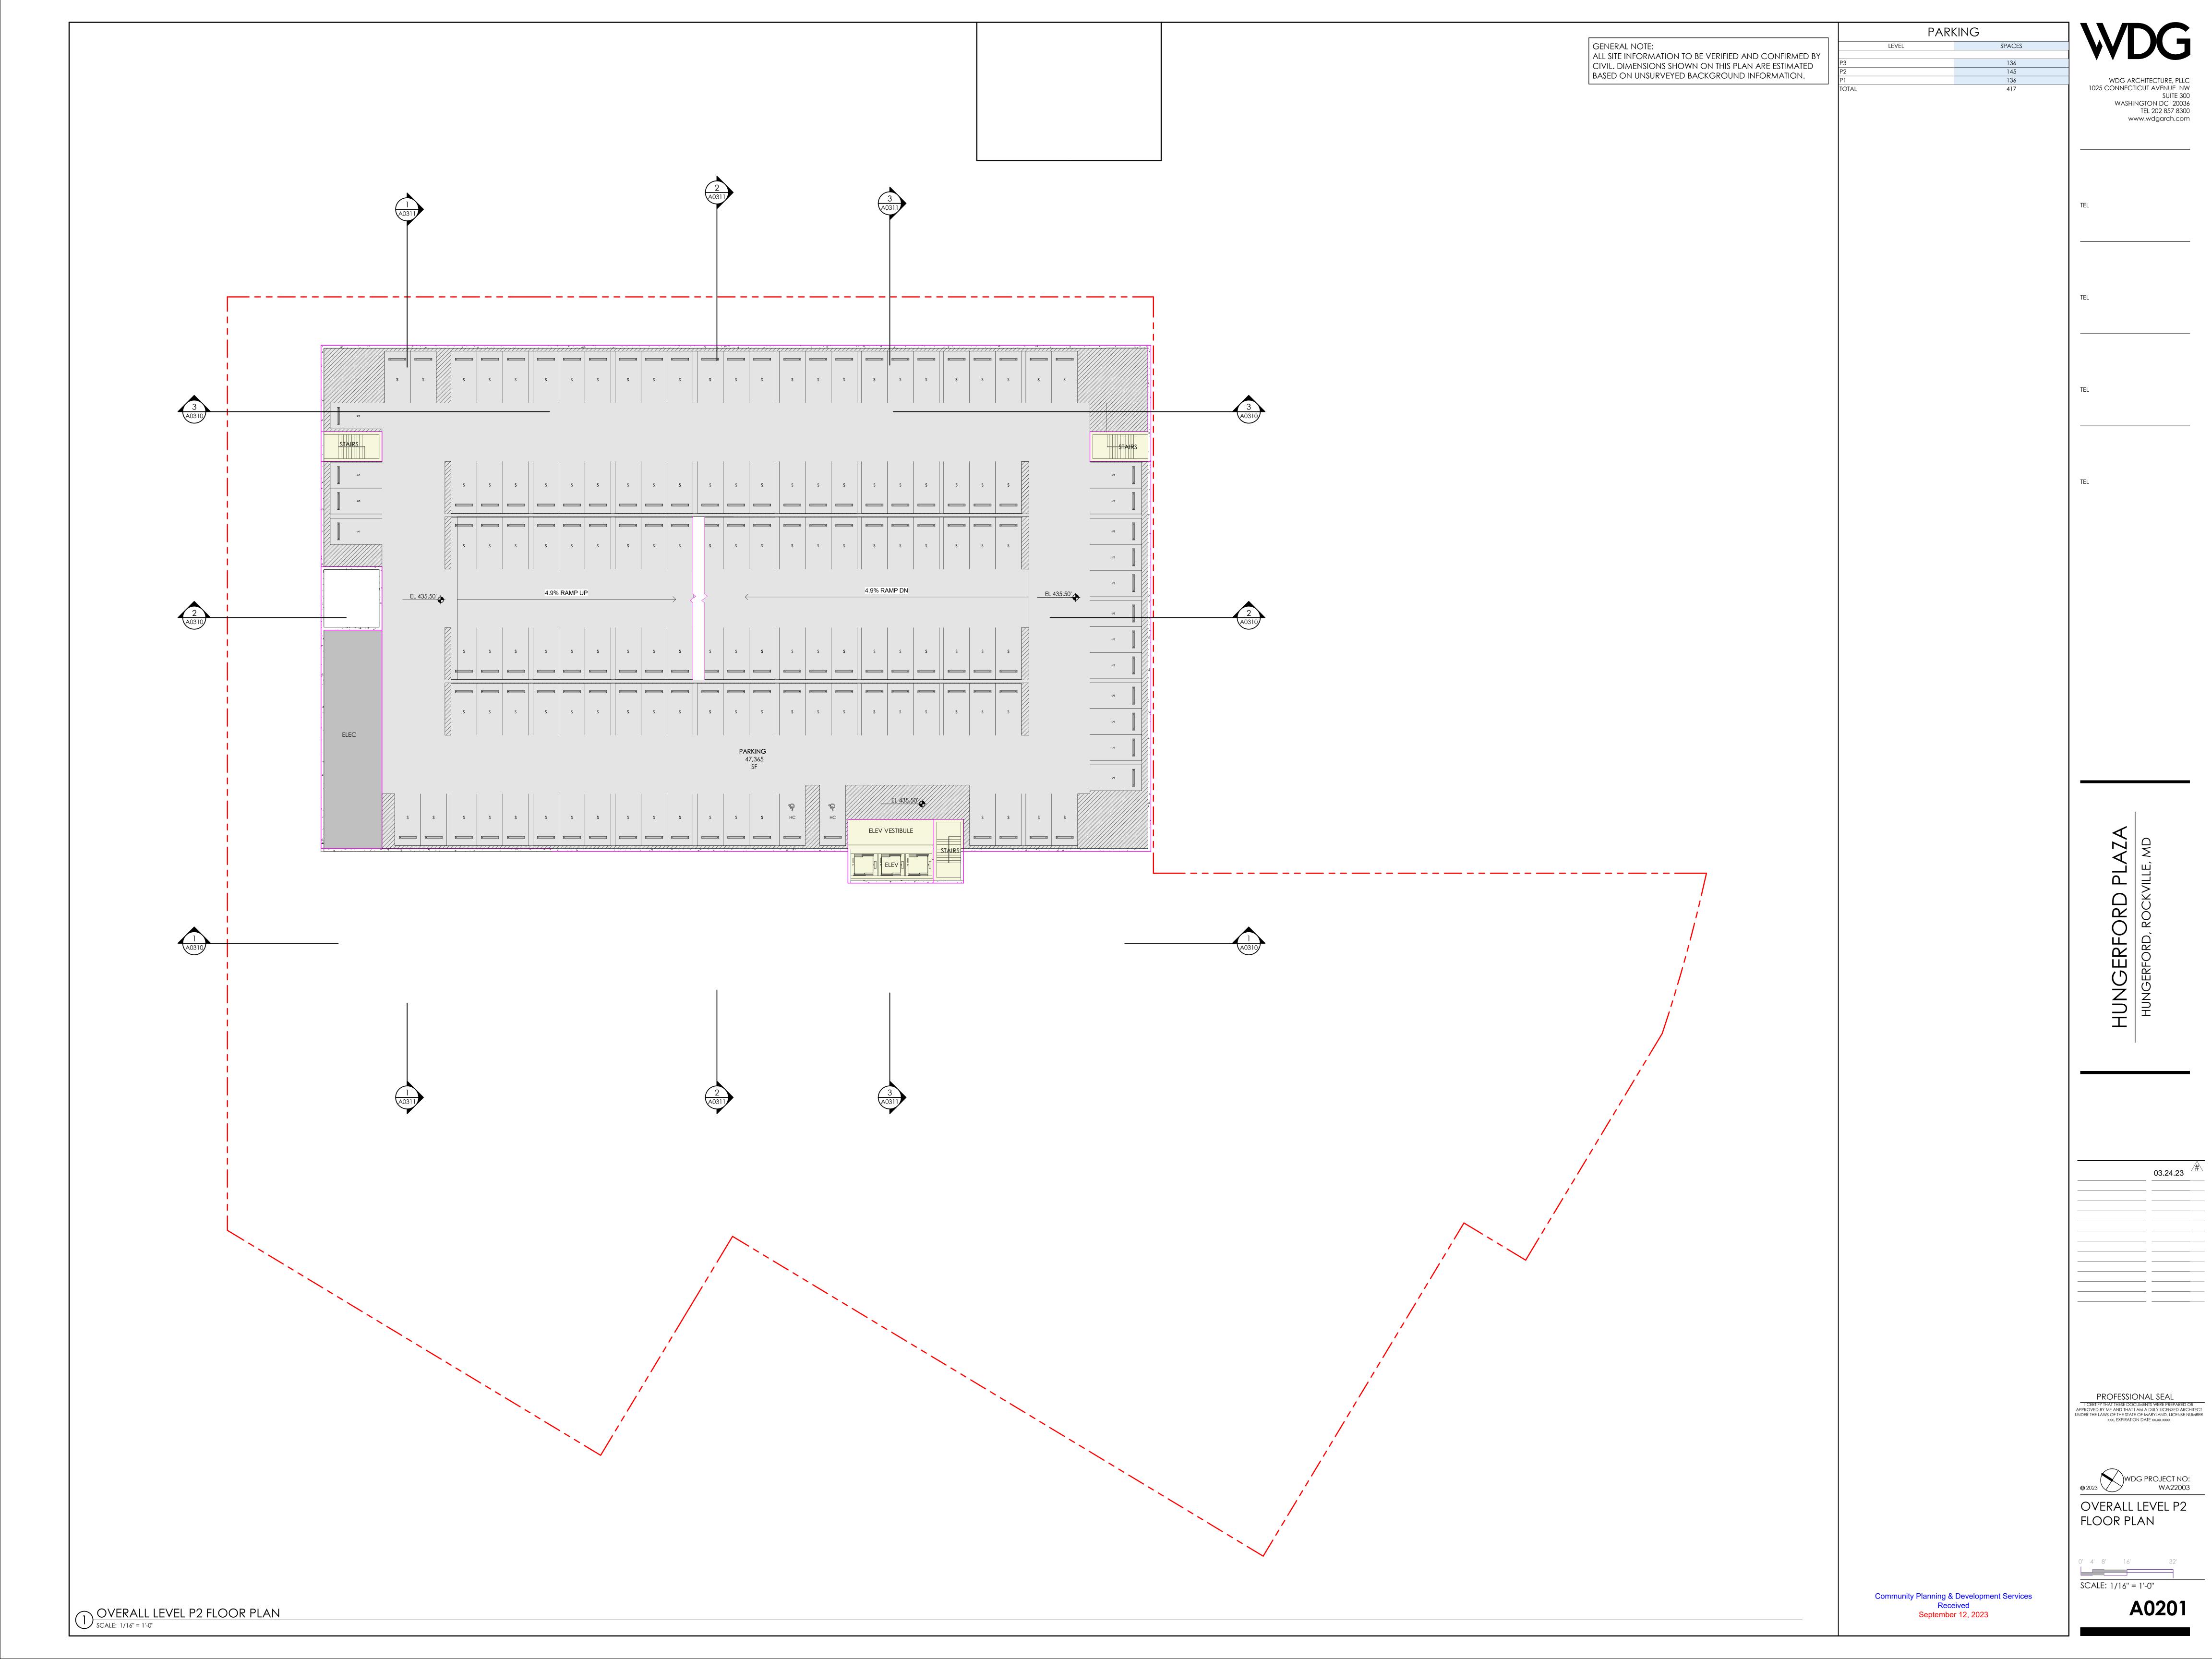

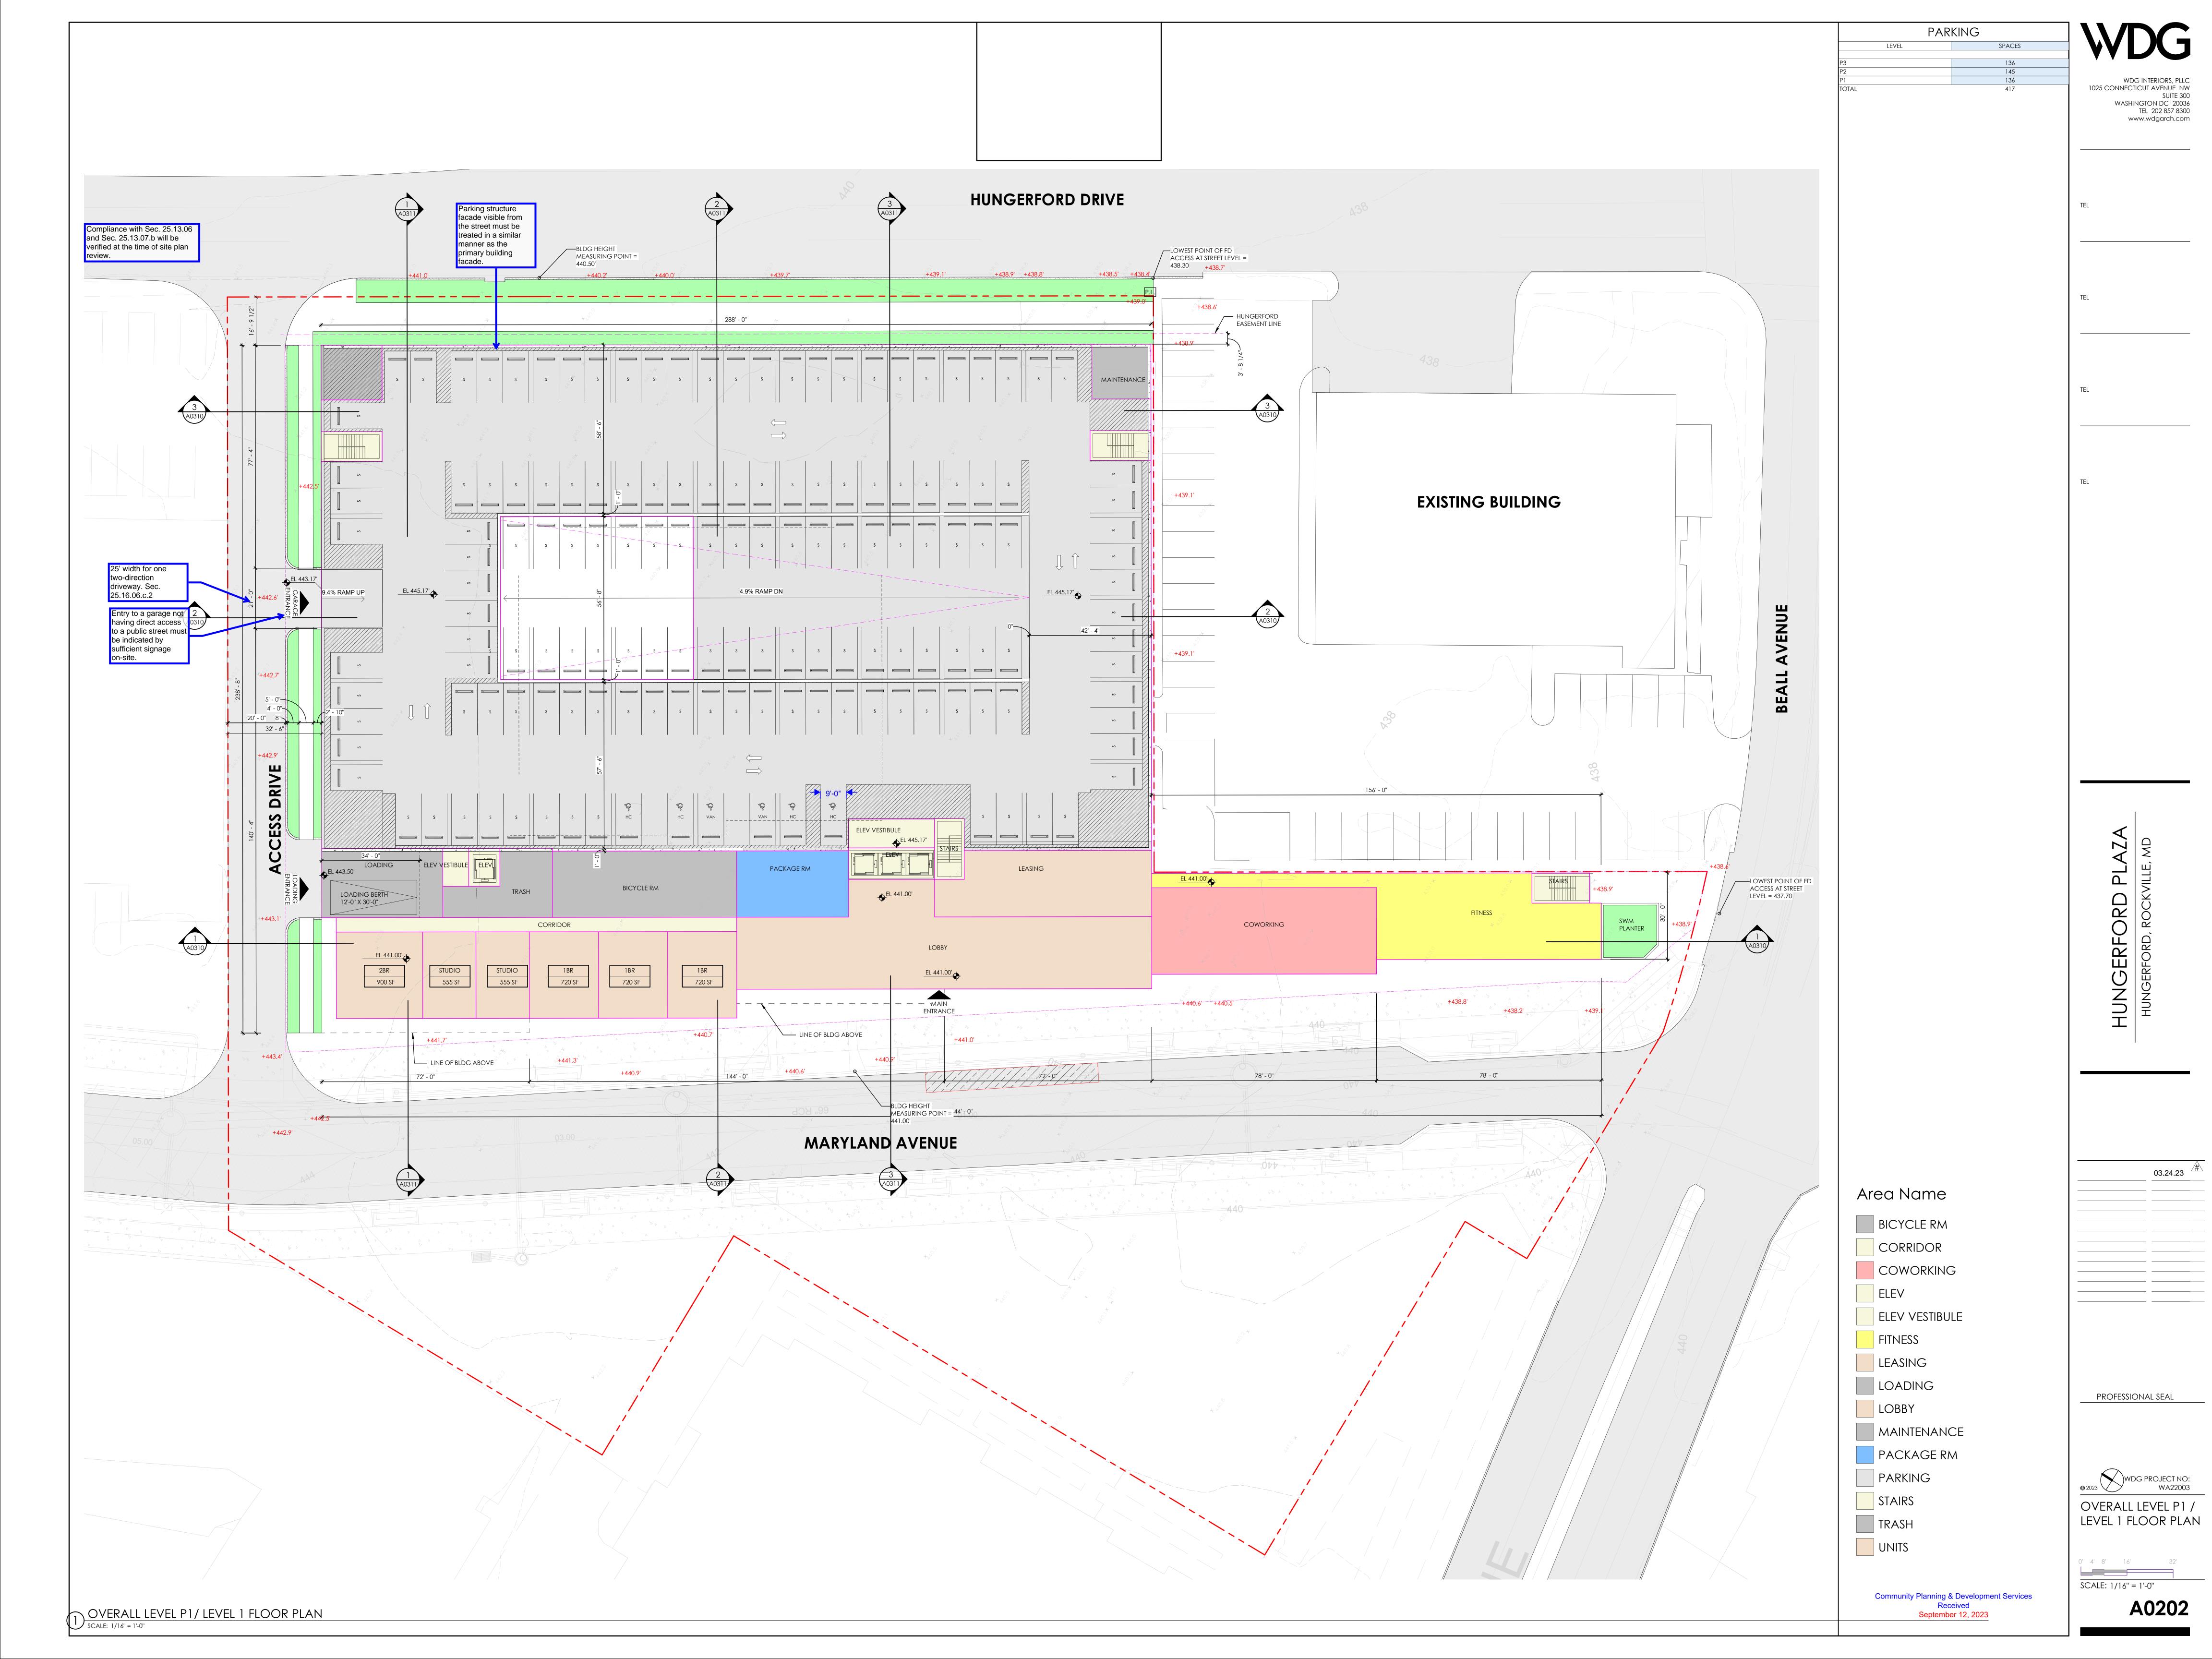

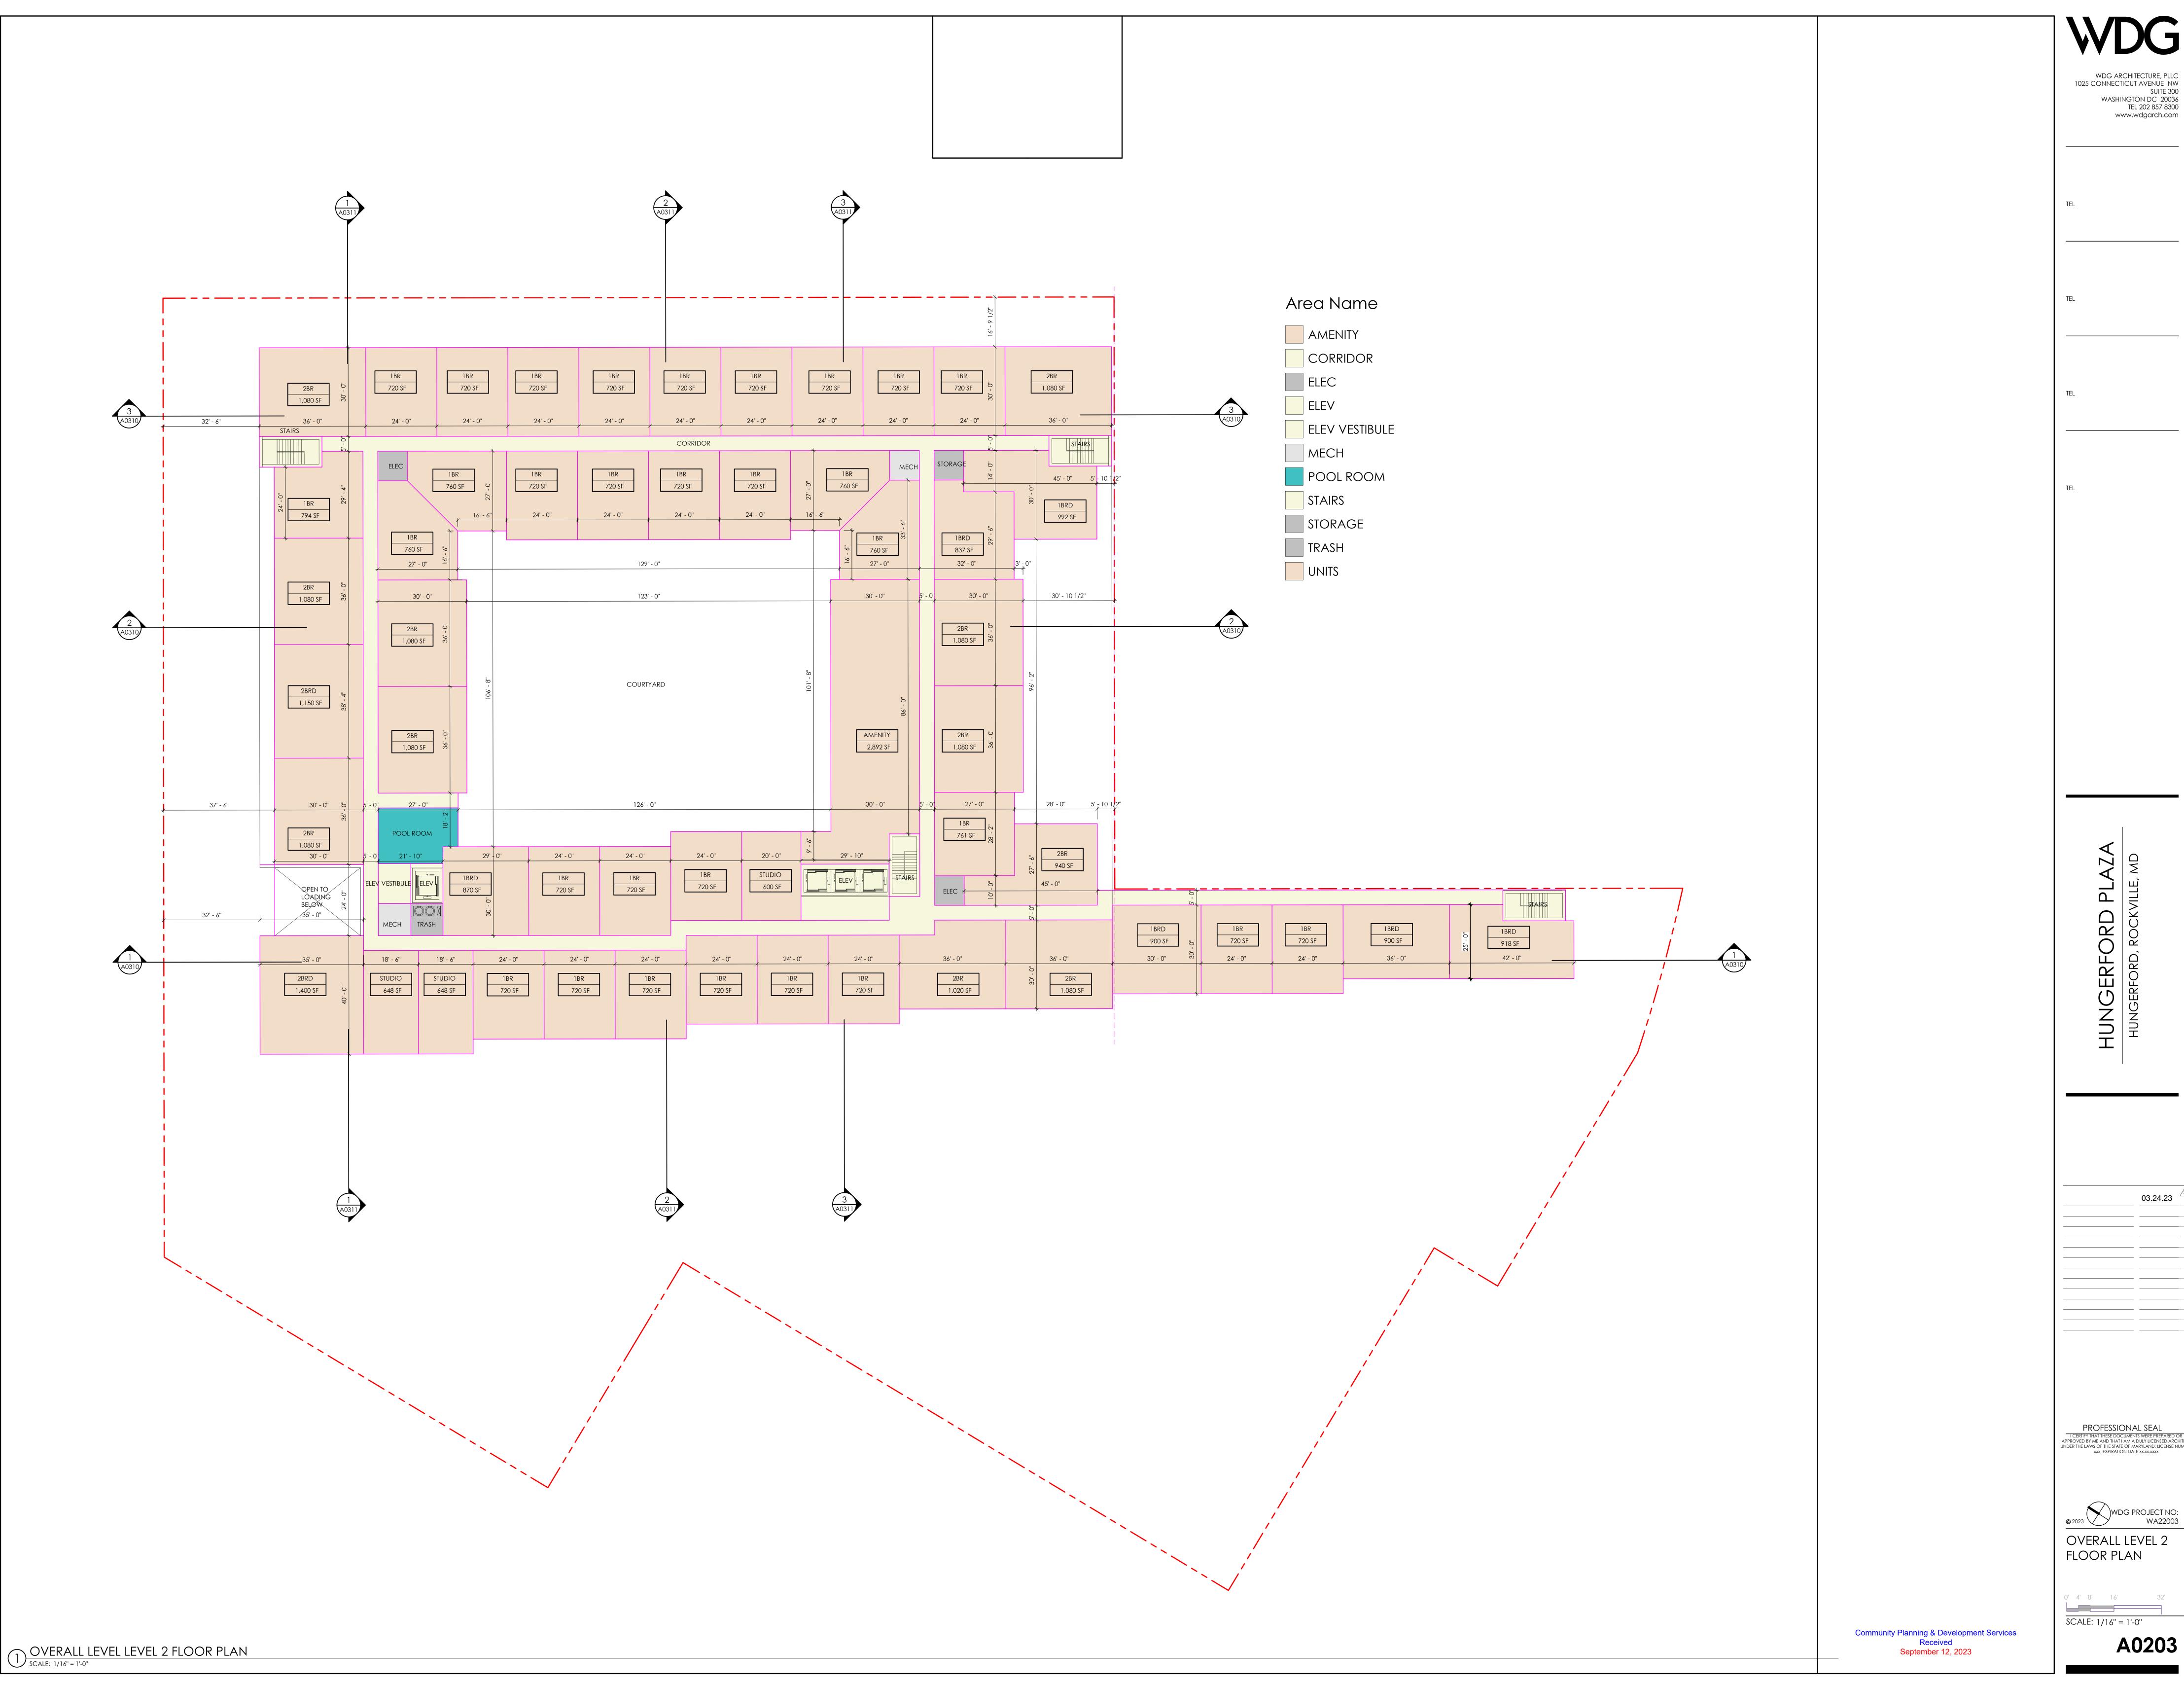


03.24.23

PROFESSIONAL SEAL

I CERTIFY THAT THESE DOCUMENTS WERE PREPARED OR APPROVED BY ME AND THAT I AM A DULY LICENSED ARCHITECT UNDER THE LAWS OF THE STATE OF MARYLAND, LICENSE NUMBER XXX, EXPIRATION DATE XX.XX.XXXX

WDG PROJECT NO: WA22003 OVERALL LEVEL 2

SCALE: 1/16" = 1'-0"

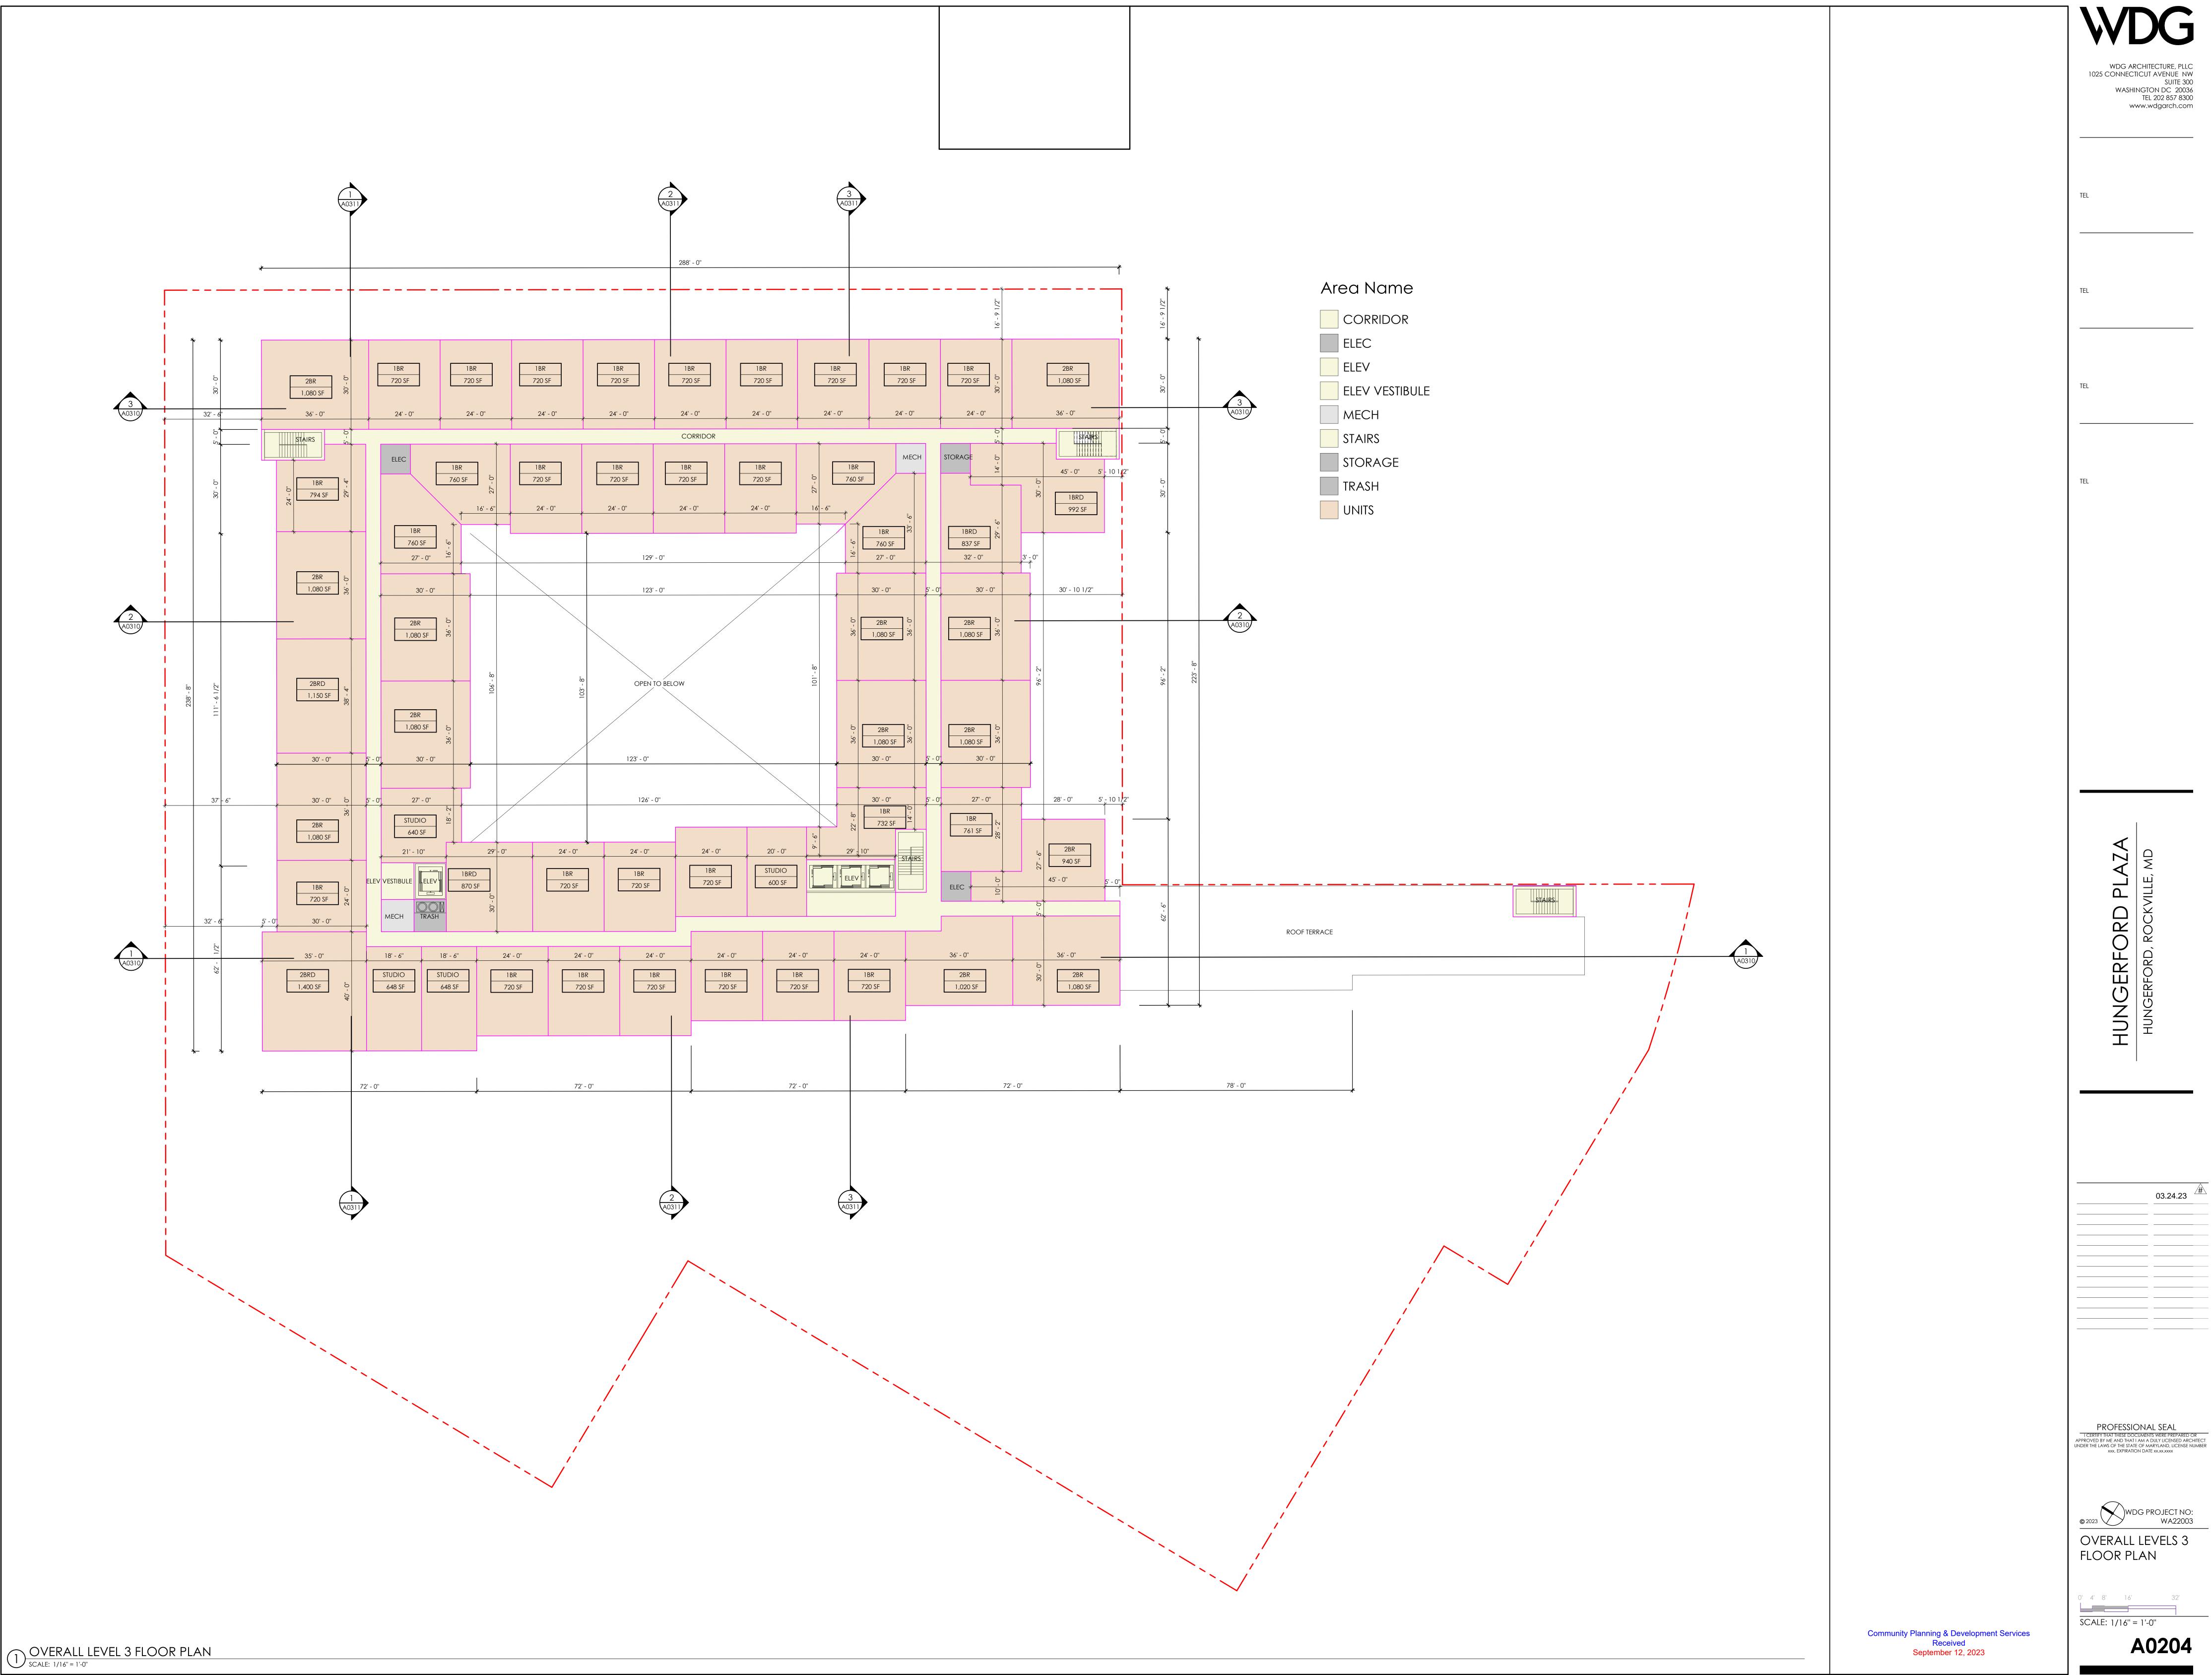


03.24.23

PROFESSIONAL SEAL

I CERTIFY THAT THESE DOCUMENTS WERE PREPARED OR

OVERALL LEVELS 3

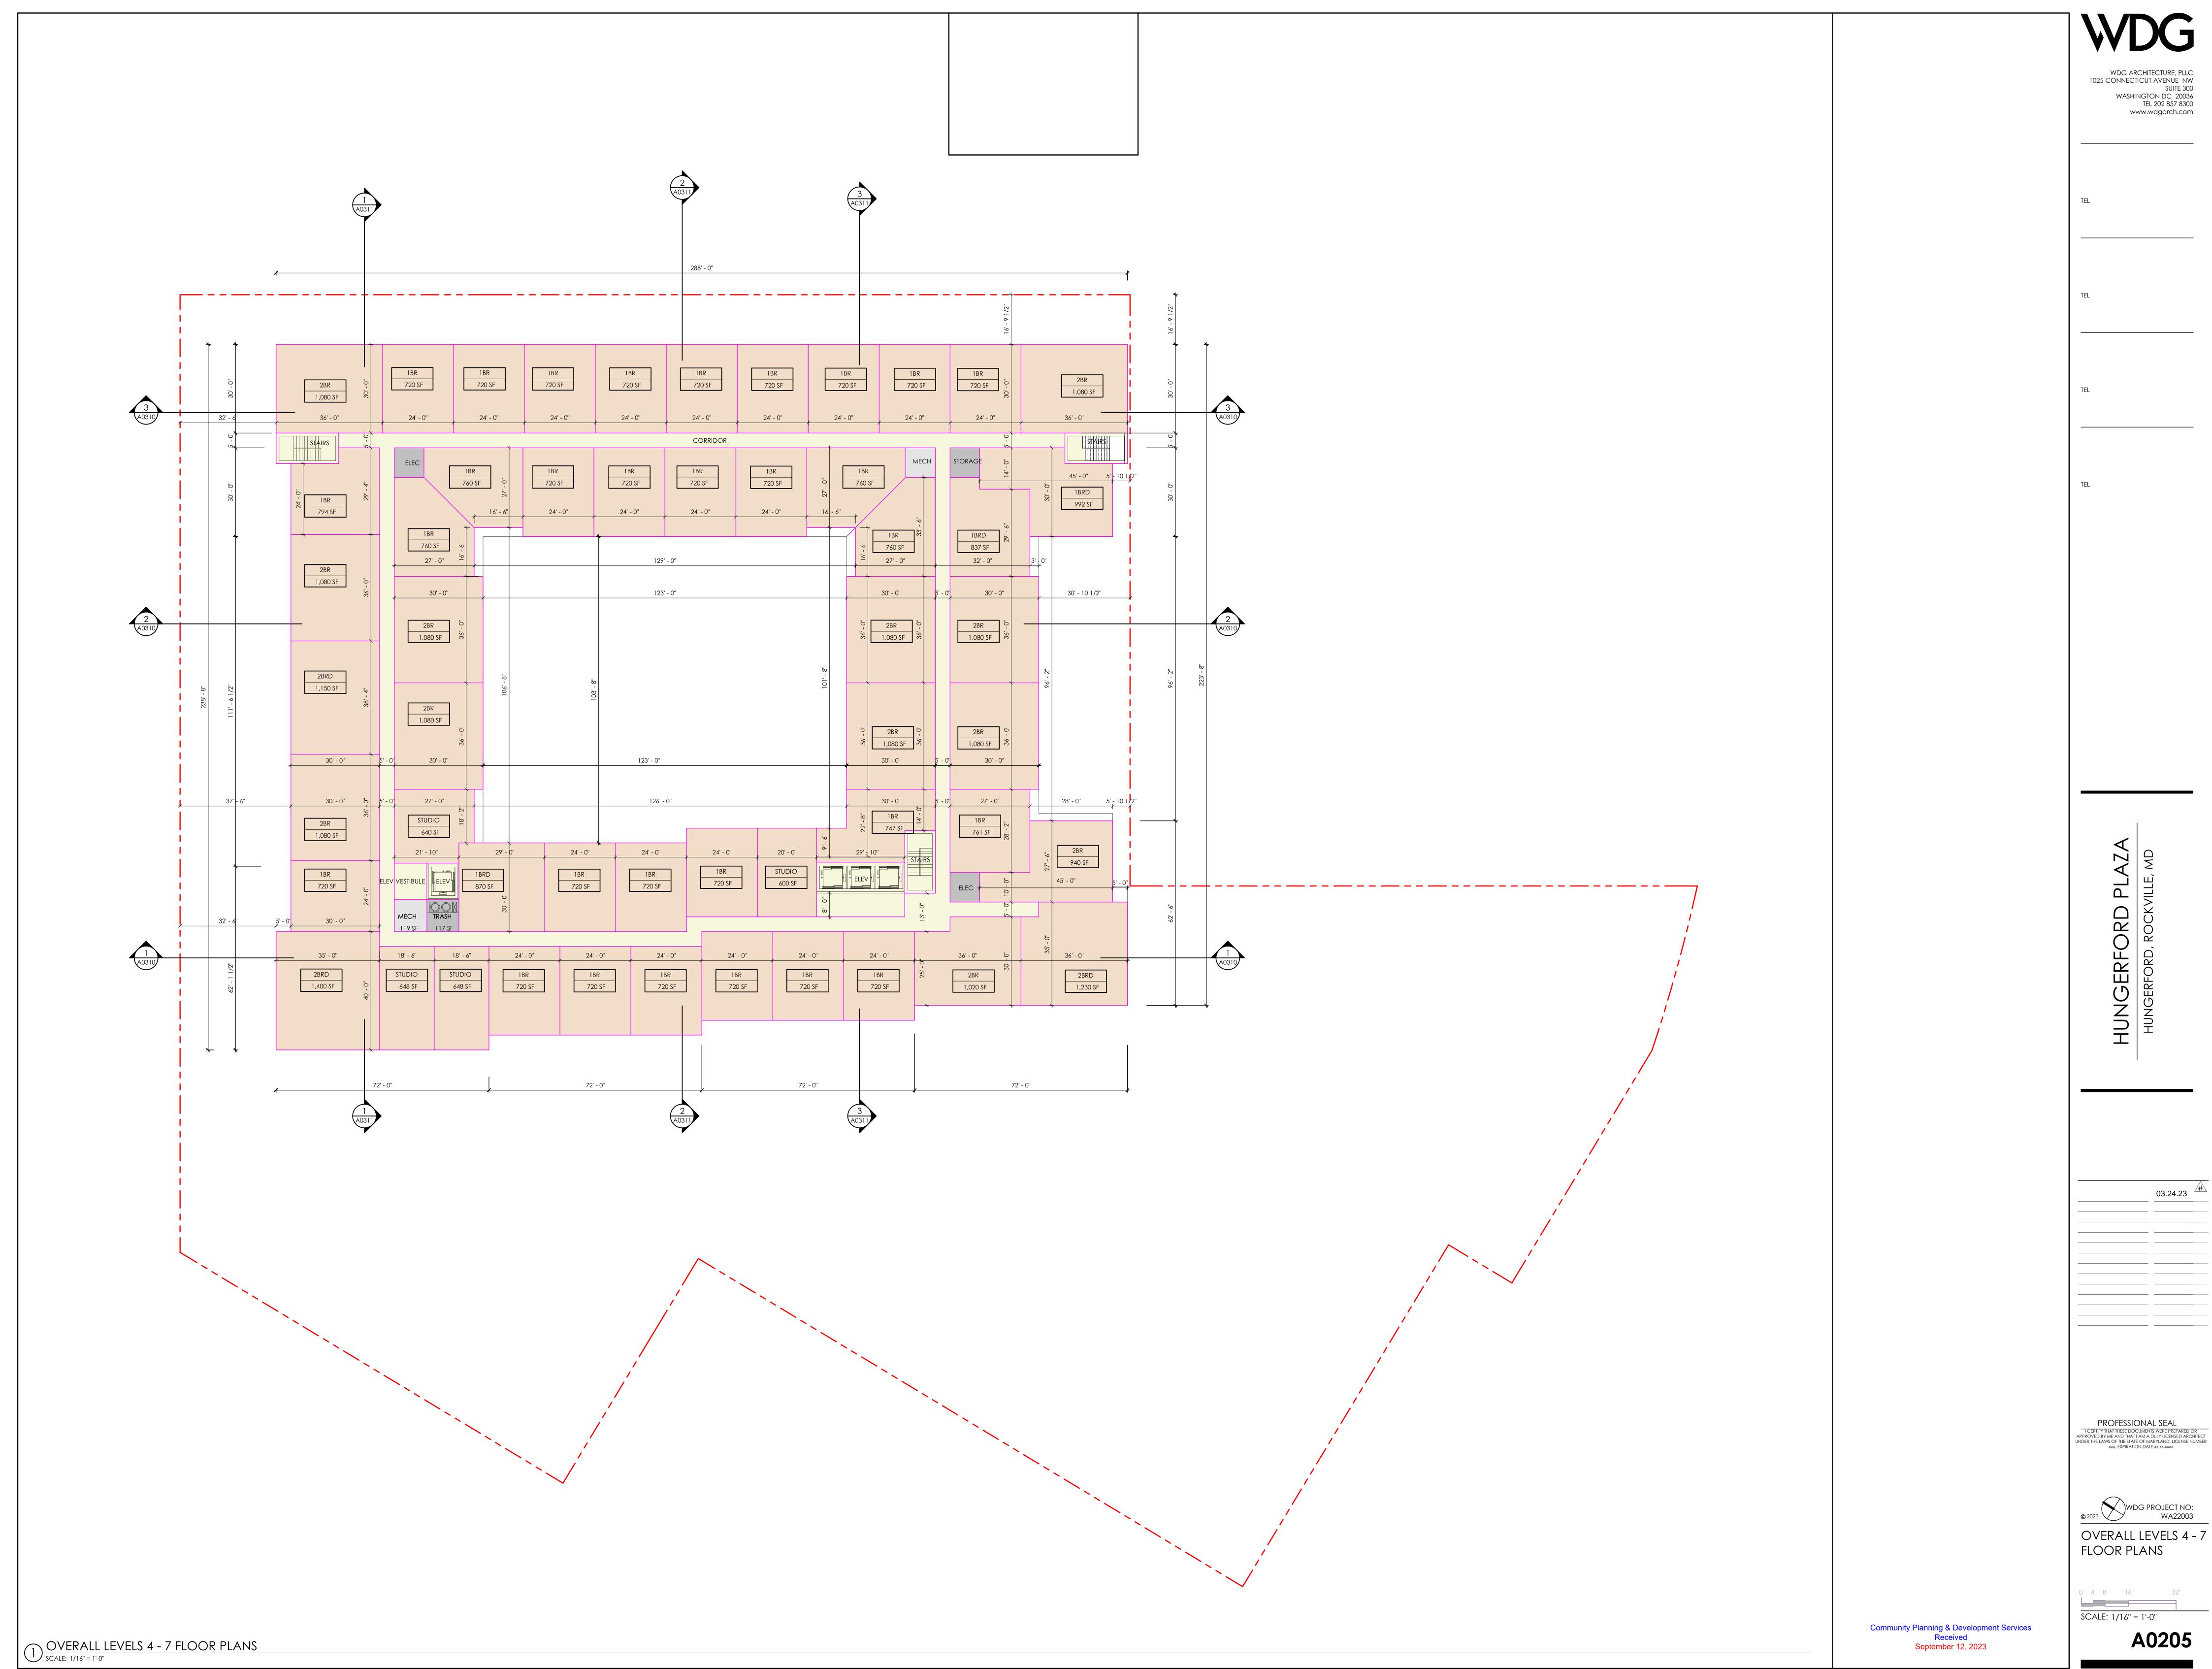


03.24.23

PROFESSIONAL SEAL

I CERTIFY THAT THESE DOCUMENTS WERE PREPARED OR

OVERALL LEVELS 4 - 7

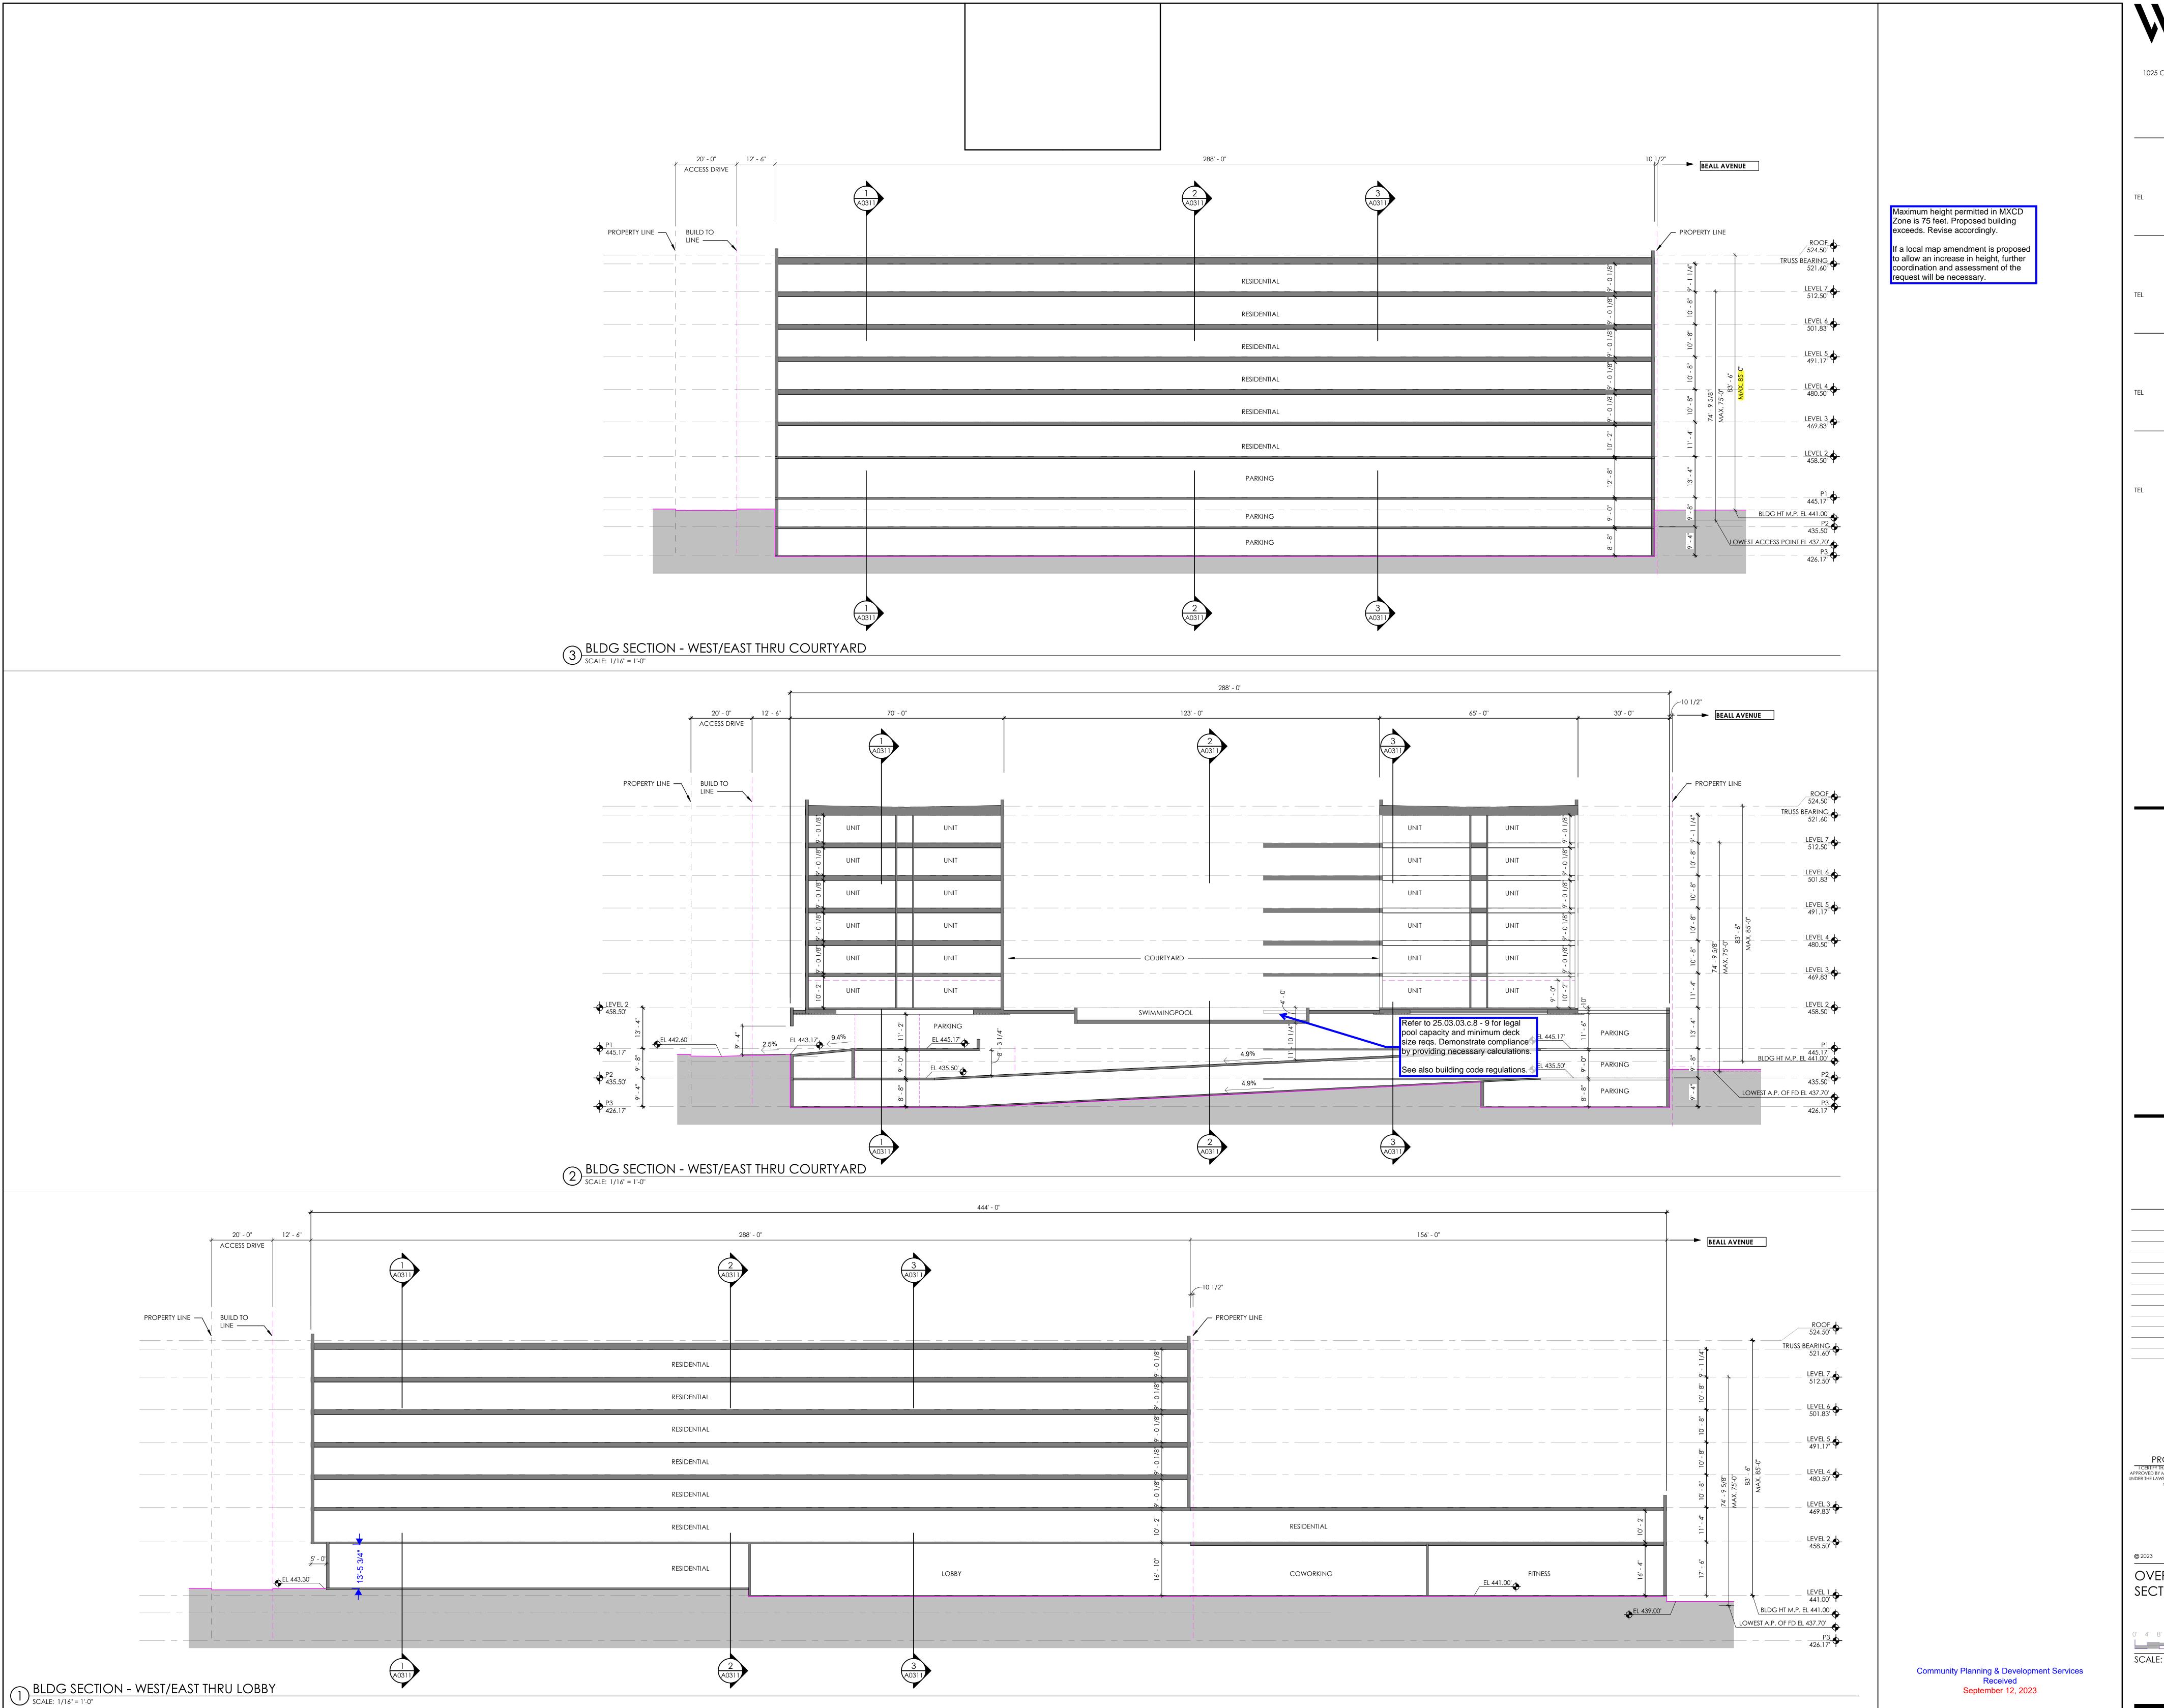

03.24.23

PROFESSIONAL SEAL


I CERTIFY THAT THESE DOCUMENTS WERE PREPARED OR

APPROVED BY ME AND THAT I AM A DULY LICENSED ARCHITECT UNDER THE LAWS OF THE STATE OF MARYLAND, LICENSE NUMBER XXX, EXPIRATION DATE XX.XX.XXXX

WDG PROJECT NO: WA22003 OVERALL BUILDING SECTIONS

SCALE: 1/16" = 1'-0"

A0310

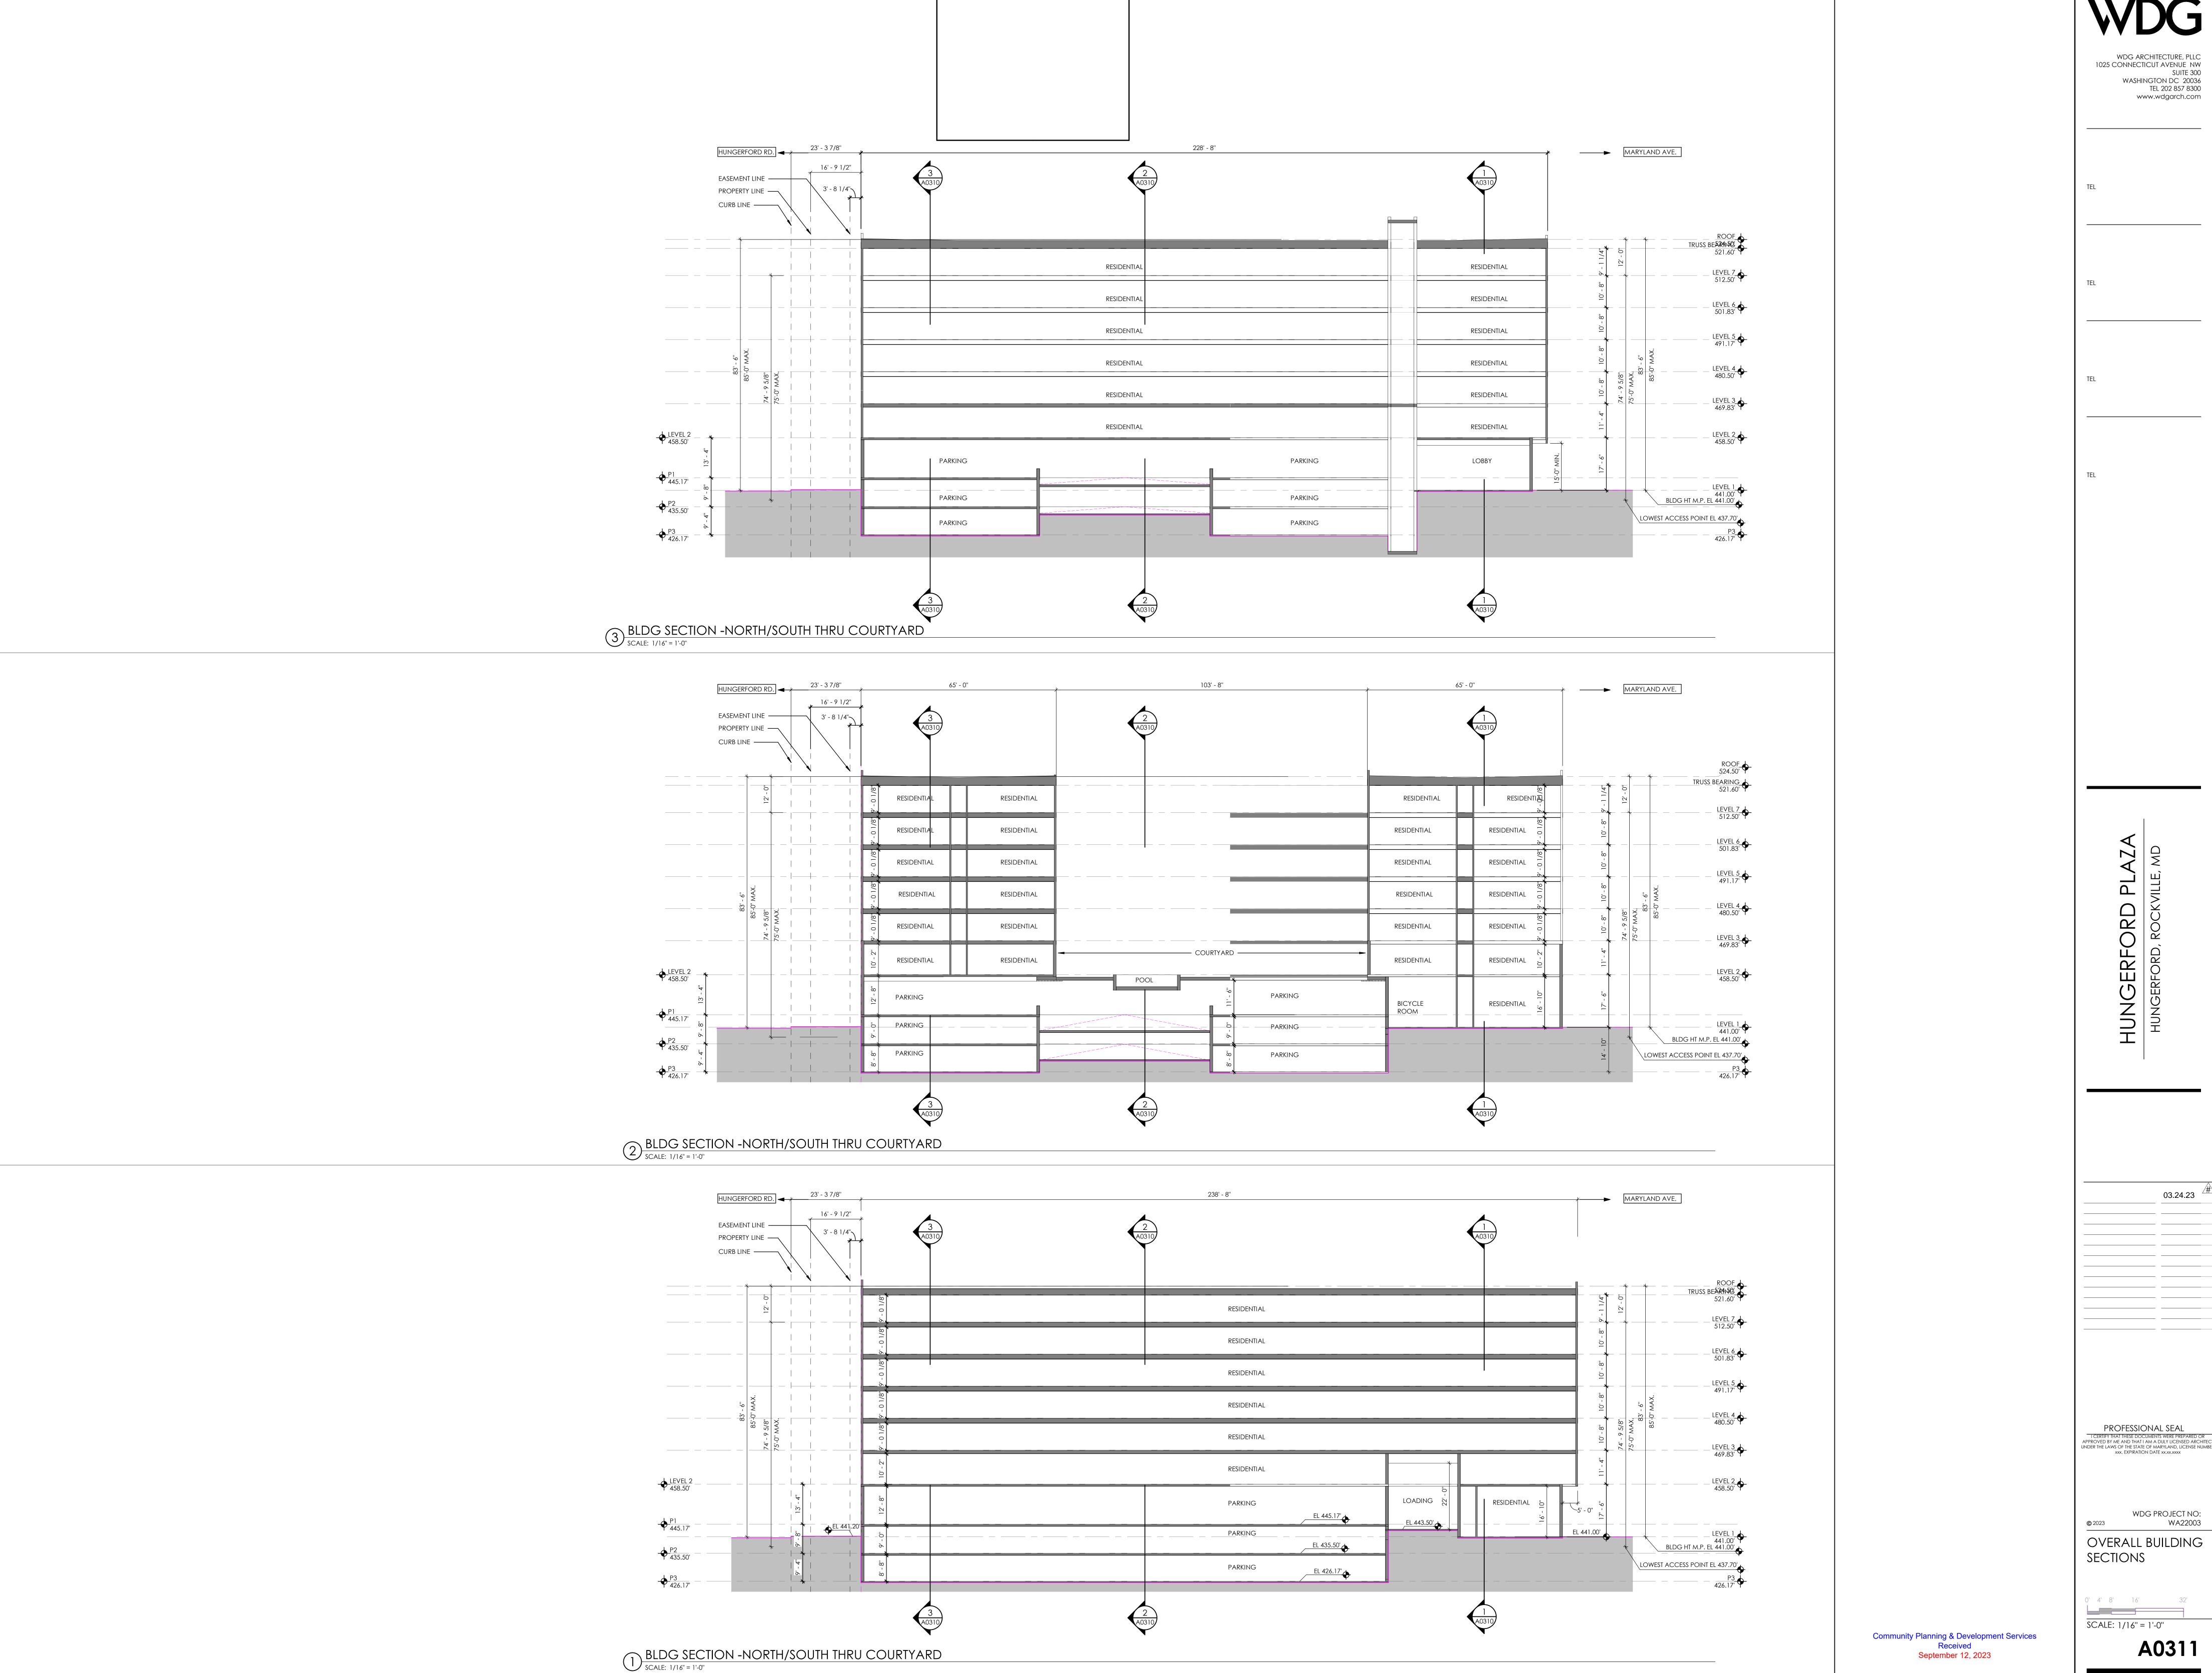

WDG ARCHITECTURE, PLLC 1025 CONNECTICUT AVENUE NW SUITE 300 WASHINGTON DC 20036 TEL 202 857 8300 www.wdgarch.com 03.24.23 PROFESSIONAL SEAL

I CERTIFY THAT THESE DOCUMENTS WERE PREPARED OR APPROVED BY ME AND THAT I AM A DULY LICENSED ARCHITECT UNDER THE LAWS OF THE STATE OF MARYLAND, LICENSE NUMBER XXX, EXPIRATION DATE XX.XX.XXXX WDG PROJECT NO: WA22003